


10-F

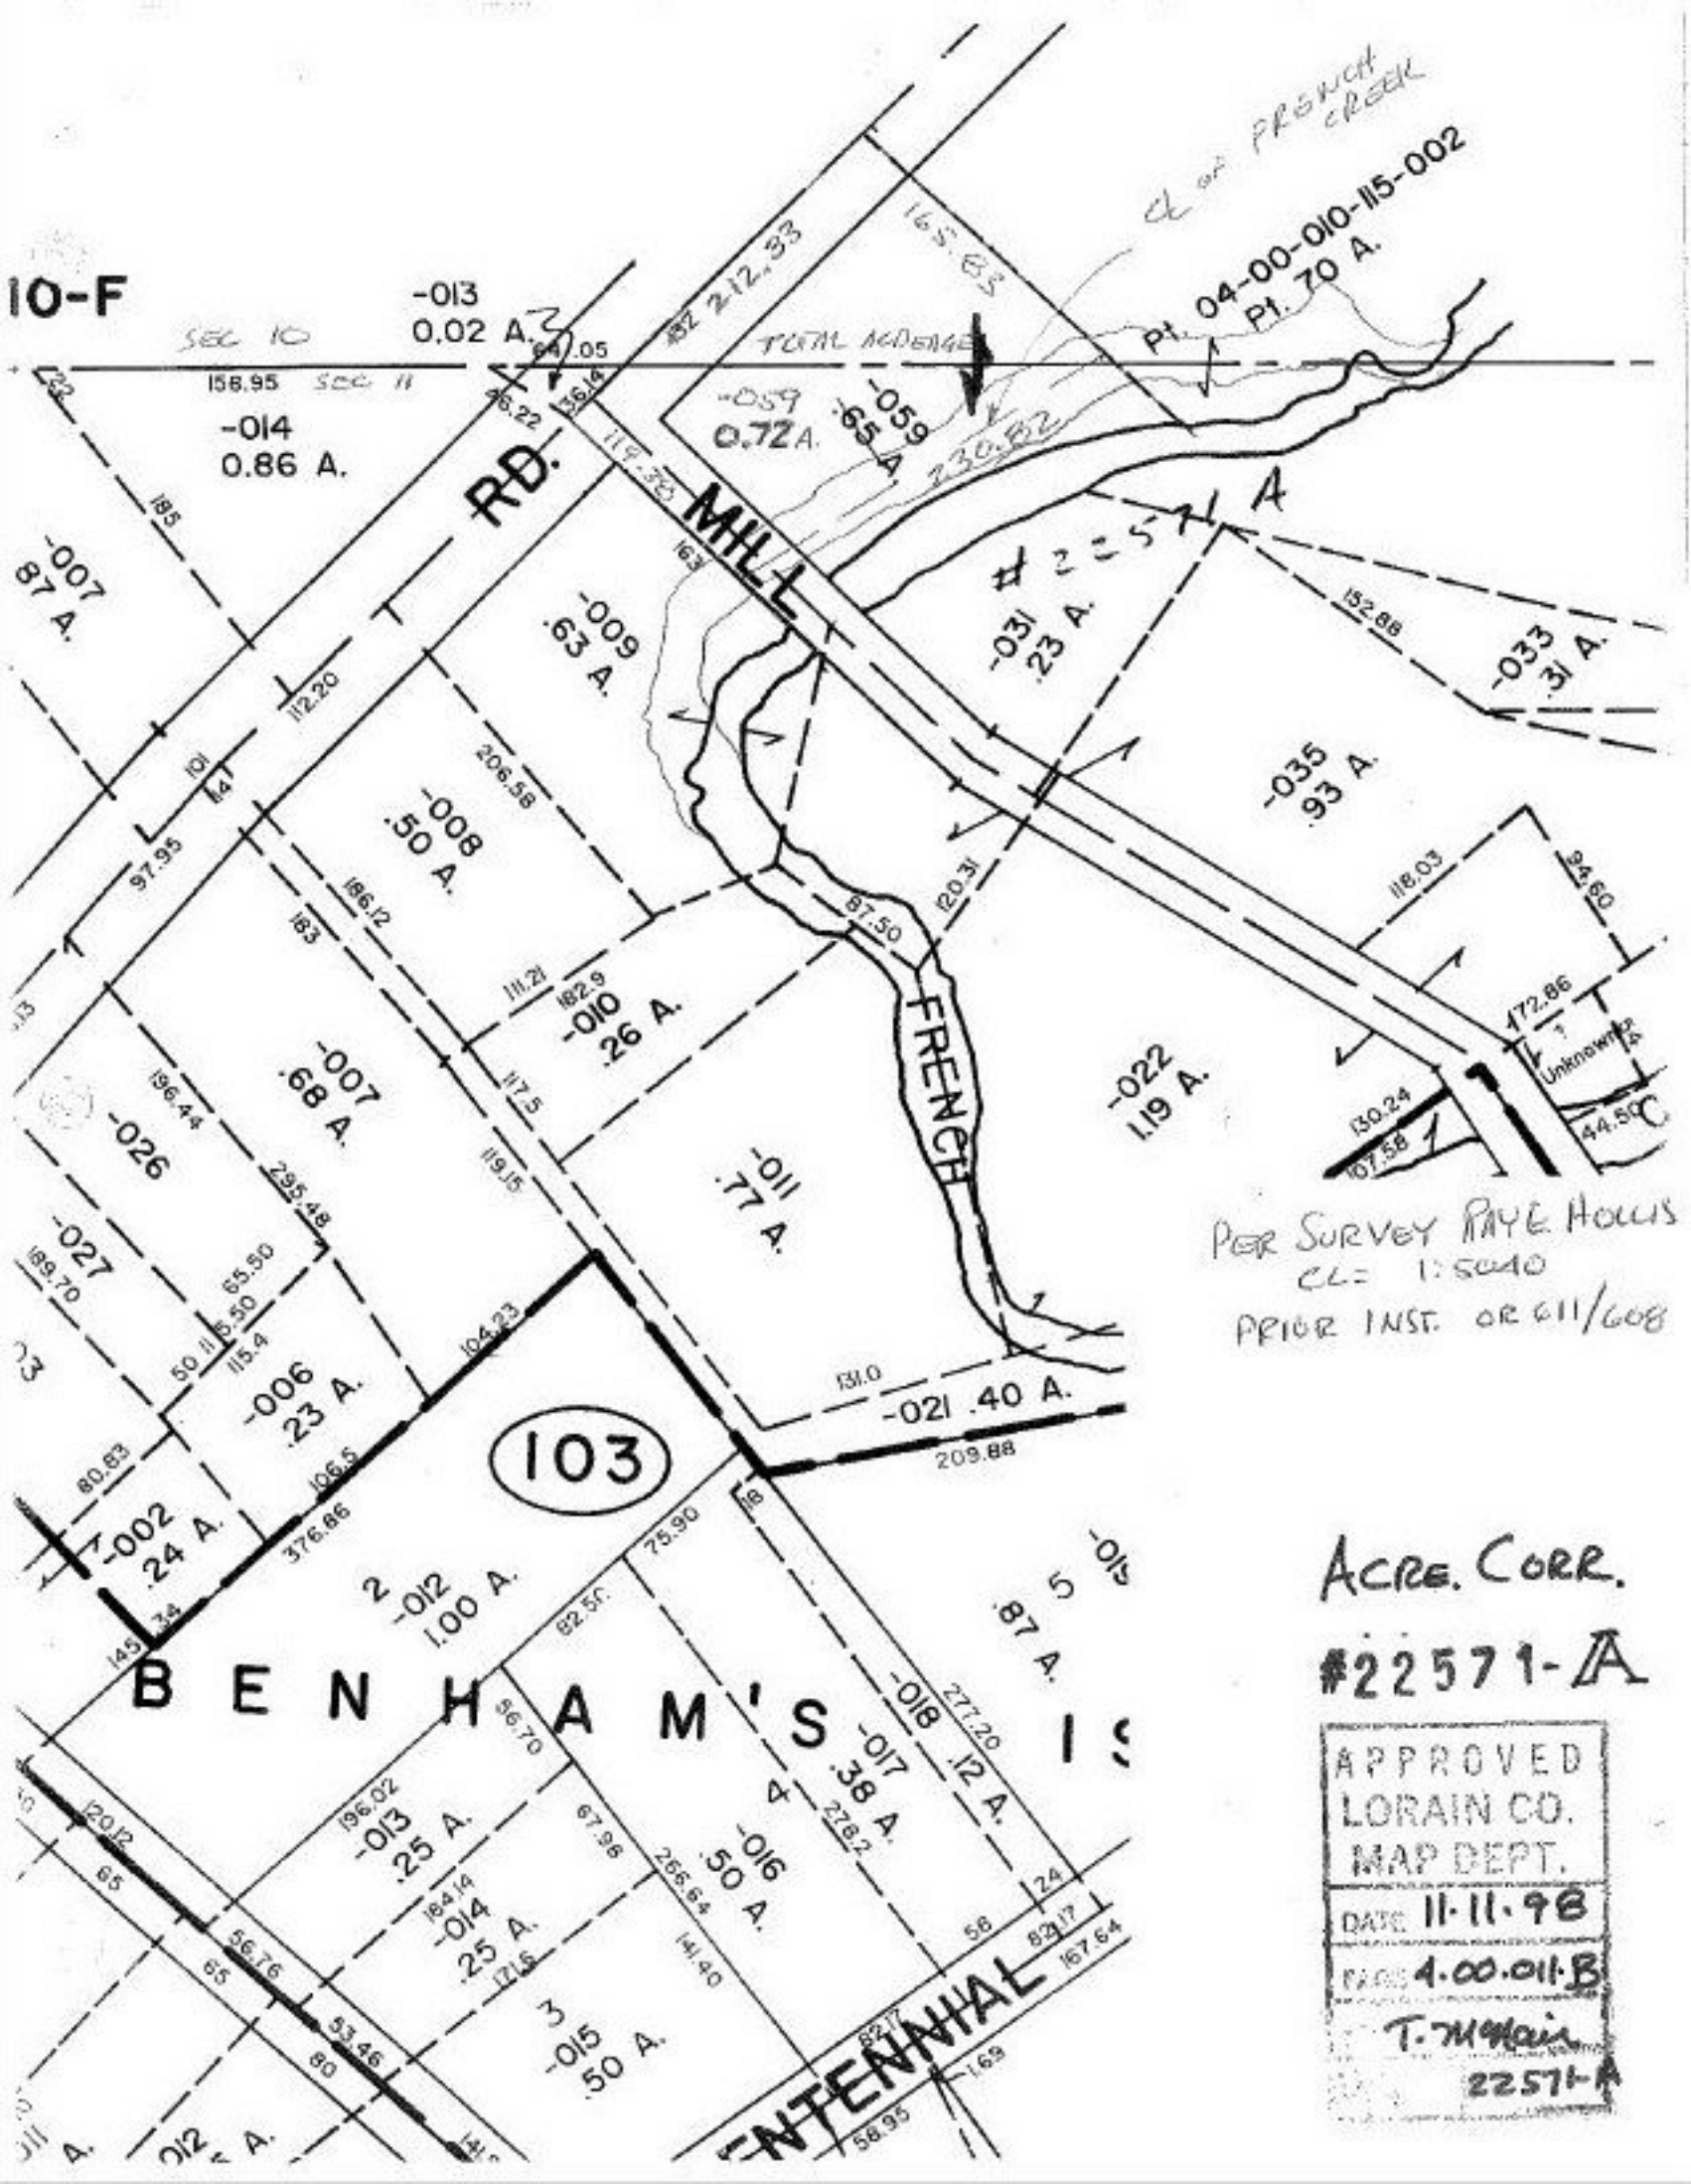

PER SURVEY RAYE HOLLIS
CL= 1:5000
PRIOR INST. OR 6/11/608

ACRE. CORR.

#22571-A

APPROVED
LORAIN CO.
MAP DEPT.
DATE 11-11-98
PAGE 4.00.011-B
T. McMain
22571-A