


PARENT PARCEL: 01-00-071-000-030, 031

CHILD PARCEL: 01-00-071-000-035

STARTING POINT: MON. BOX IN CL. OF BAUMHART RD. & ITS INTERSECTION WITH SOUTH LINE O.L. 71

NO. 22572-D

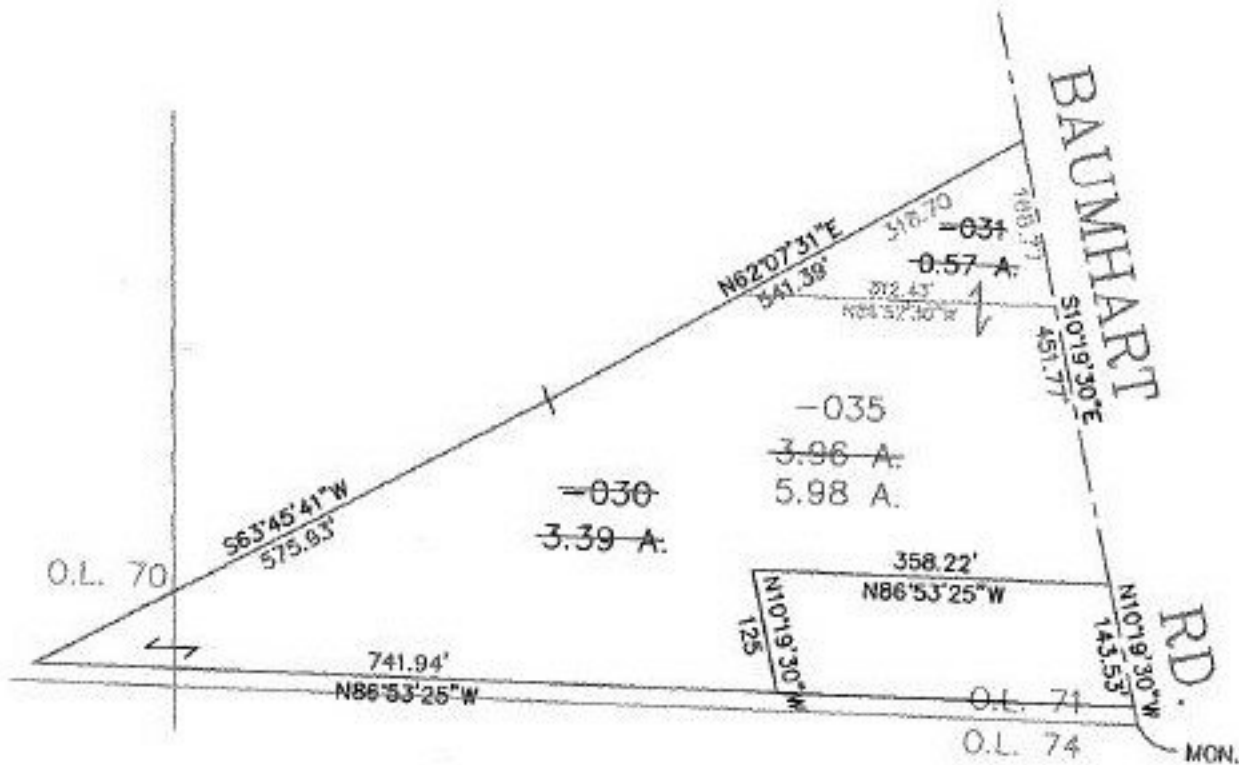

2-19-99



**SPLITS/DEEDS PROCESSED**  
 LORAIN COUNTY TAX MAP DEPARTMENT  
 226 MIDDLE AVE. ELYRIA, OHIO

SURVEYED BY: JAMES B. ROBERTS  
 CLOSURE: 0.02 : 10.000  
 MAP PAGE(S): 1-1  
 APPROVED BY: TJS DATE: 06/23/98  
 SCALE: 1" = 200' PRIOR INSTRUMENT: 980540076