

PARENT PARCEL: 07-00-002-102-014


CHILD PARCEL: XX-XX-XXX-XXX-XXX

STARTING POINT: CL OF BEREA RD. & N.E. CORNER OF LAND CONVEYED RO ALEXANDER

NO. 22576-D

MAP CORRECTION

DEPTH CORR.

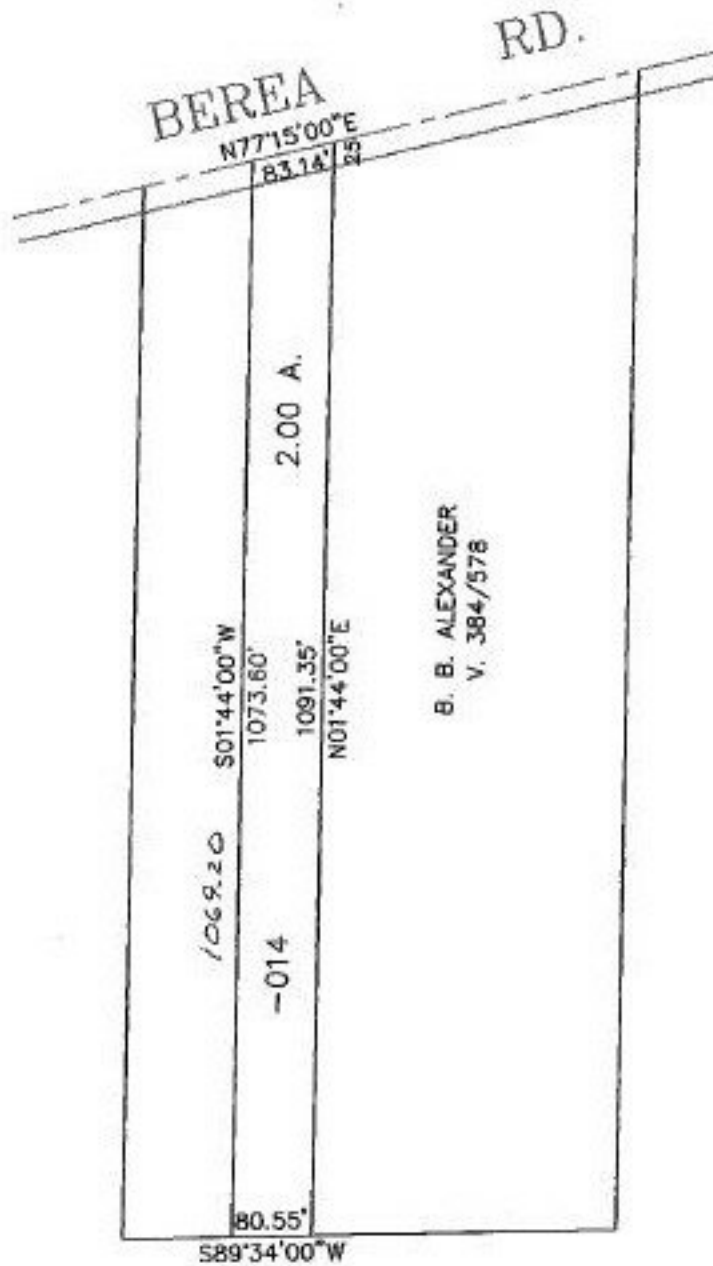

SEE ALSO  
 DV 759/342  
 DV 811/493  
 DV 1169/354  
 DV 1286/62  
 DV 1316/203



**SPLITS/DEEDS PROCESSED**  
 LORAIN COUNTY TAX MAP DEPARTMENT  
 226 MIDDLE AVE. ELYRIA, OHIO

SURVEYED BY: C. T. BIGGS  
 CLOSURE: 0.03 : 10,000  
 MAP PAGE(S): 07-00-002-A  
 APPROVED BY: TJS DATE: 07/06/98  
 SCALE: 1" = 200' PRIOR INSTRUMENT: DV 1286/62