
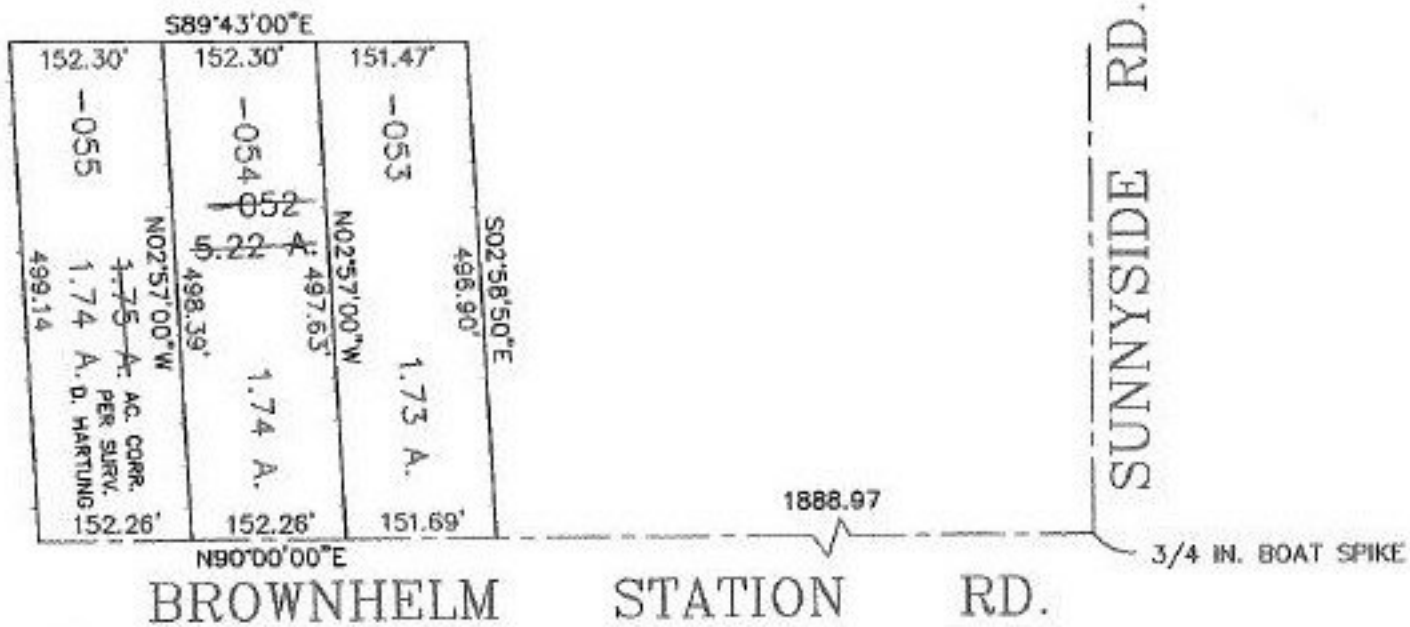


PARENT PARCEL: 01-00-013-000-052

CHILD PARCEL: 01-00-013-000-053 THRU 055

STARTING POINT: 3/4 IN. BOAT SPIKE, IN CL. OF BROWNHELM STATION RD. & CL. OF SUNNYSIDE RD.

NO. 22576

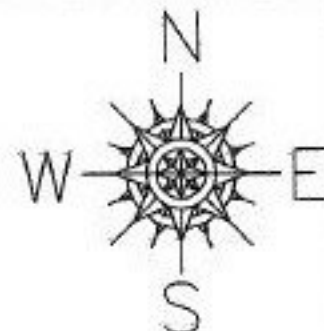

SPLITS/DEEDS PROCESSED
 LORAIN COUNTY TAX MAP DEPARTMENT
 226 MIDDLE AVE. ELYRIA, OHIO

SURVEYED BY: DANIEL E. HARTUNG JR.
 CLOSURE: 0.06 : 10,000
 MAP PAGE(S): 1-8
 APPROVED BY: TJS DATE: 07/06/98
 SCALE: 1" = 200' PRIOR INSTRUMENT: 980210536