

PARENT PARCEL: 02-01-003-126-002

CHILD PARCEL: XX-XX-XXX-XXX-XXX


STARTING POINT: N.E. CORNER OF S\1 OF BLOCK 126

NO. 22581-D



DEED CHECK

THESE LEGALS DESCRIBE PART OF
P.P. 02-01-003-126-002
EASEMENTS

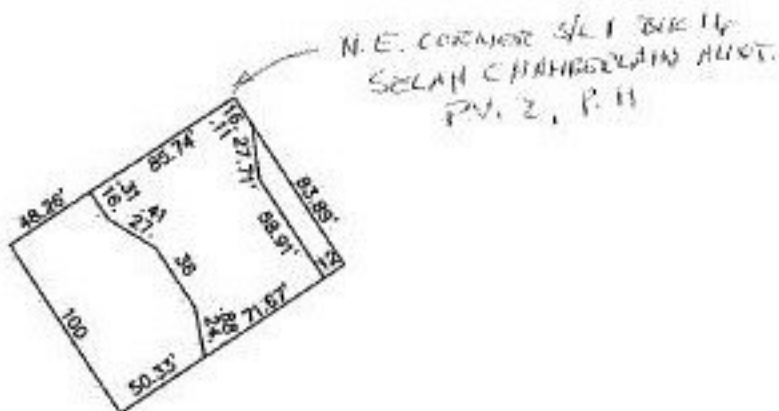

TJ
2-25-99



SPLITS/DEEDS PROCESSED
LORAIN COUNTY TAX MAP DEPARTMENT
226 MIDDLE AVE. ELYRIA, OHIO

SURVEYED BY: THOMAS F. MOSURE
CLOSURE: 0.25 : 10,000
MAP PAGE(S): 02-01-003-C
APPROVED BY: TJS DATE: 07/10/98
SCALE: 1" = 100' PRIOR INSTRUMENT: DV 287/33