


PARENT PARCEL: 07-00-004-108-076

CHILD PARCEL: 07-00-004-108-082 & 083

STARTING POINT: CL OF CHESTNUT RIDGE RD. & CL OF LEAR NAGLE RD.

NO. 22581

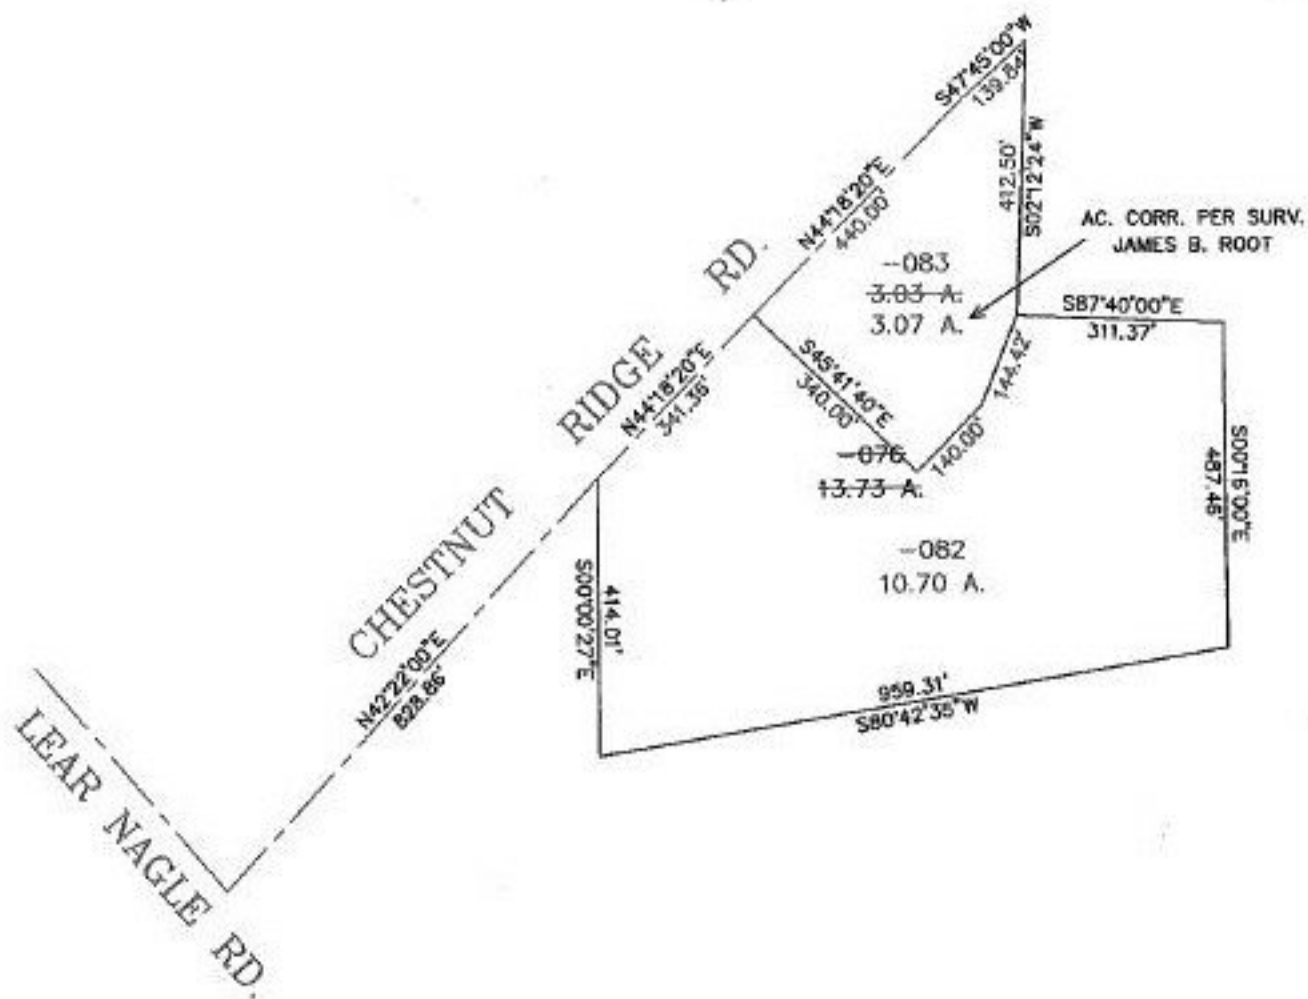

SPLITS/DEEDS PROCESSED

LORAIN COUNTY TAX MAP DEPARTMENT
226 MIDDLE AVE. ELYRIA, OHIO

SURVEYED BY: JAMES B. ROOT

CLOSURE: 0.01 : 10,000

MAP PAGE(S): 07-00-004-A & B & C & D

APPROVED BY: IJS DATE: 07/09/98

SCALE: 1" = 300' PRIOR INSTRUMENT: OR 1212/932