


PARENT PARCEL: 03-00-063-000-056 & -058
CHILD PARCEL: 03-00-063-000-059 THRU -062
STARTING POINT: BEGINING AT THE N.W. CORNER OF MARCUS DR. AS PRESENTLY DEDICATED

NO. 22584

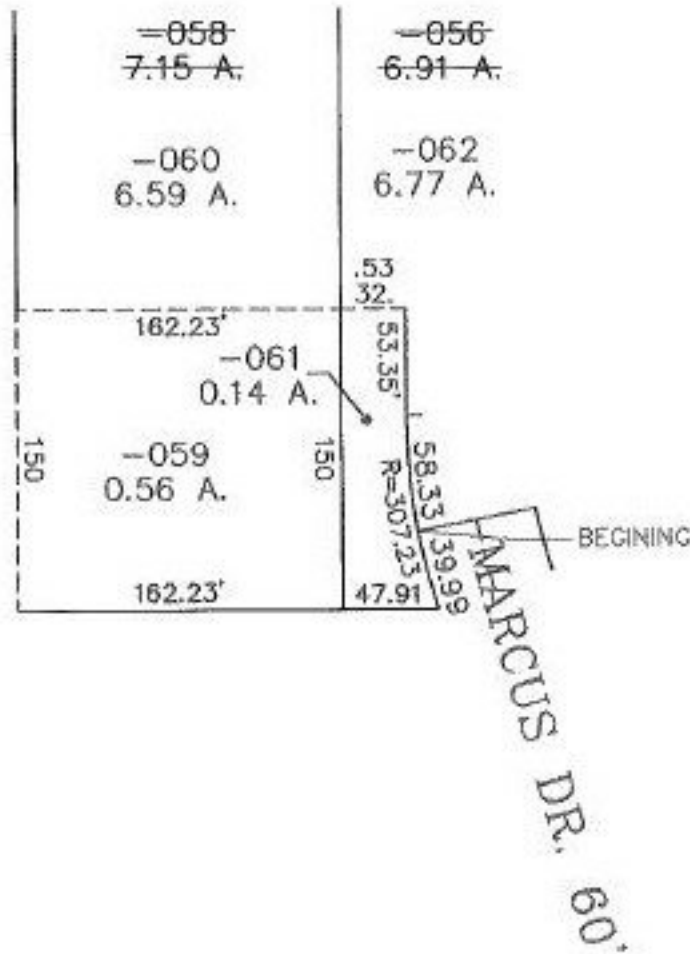

SPLITS/DEEDS PROCESSED
LORAIN COUNTY TAX MAP DEPARTMENT
226 MIDDLE AVE. ELYRIA, OHIO

SURVEYED BY: M. G. HURA
CLOSURE: 0.00 : 10,000
MAP PAGE(S): 03-00-063
APPROVED BY: TJS DATE: 09/22/98
SCALE: 1" = 100' PRIOR INSTRUMENT: DY 950/520