


PARENT PARCEL: 04-00-015-108-007, 017, 041, 042, (019-st.tr.)
 CHILD PARCEL: 04-00-015-108-043, 044, 045, (019 st.tr.)
 STARTING POINT: 1. NORTHEASTERLY CORNER OF BLOCK A IN SCHAFER-IRWIN SUB.NO.1, 42/62
 2. C/L OF DETROIT ROAD & W. LINE OF O.L. 15

NO. 22586



3 BLOCK A IS A STRAIGHT TRANSFER

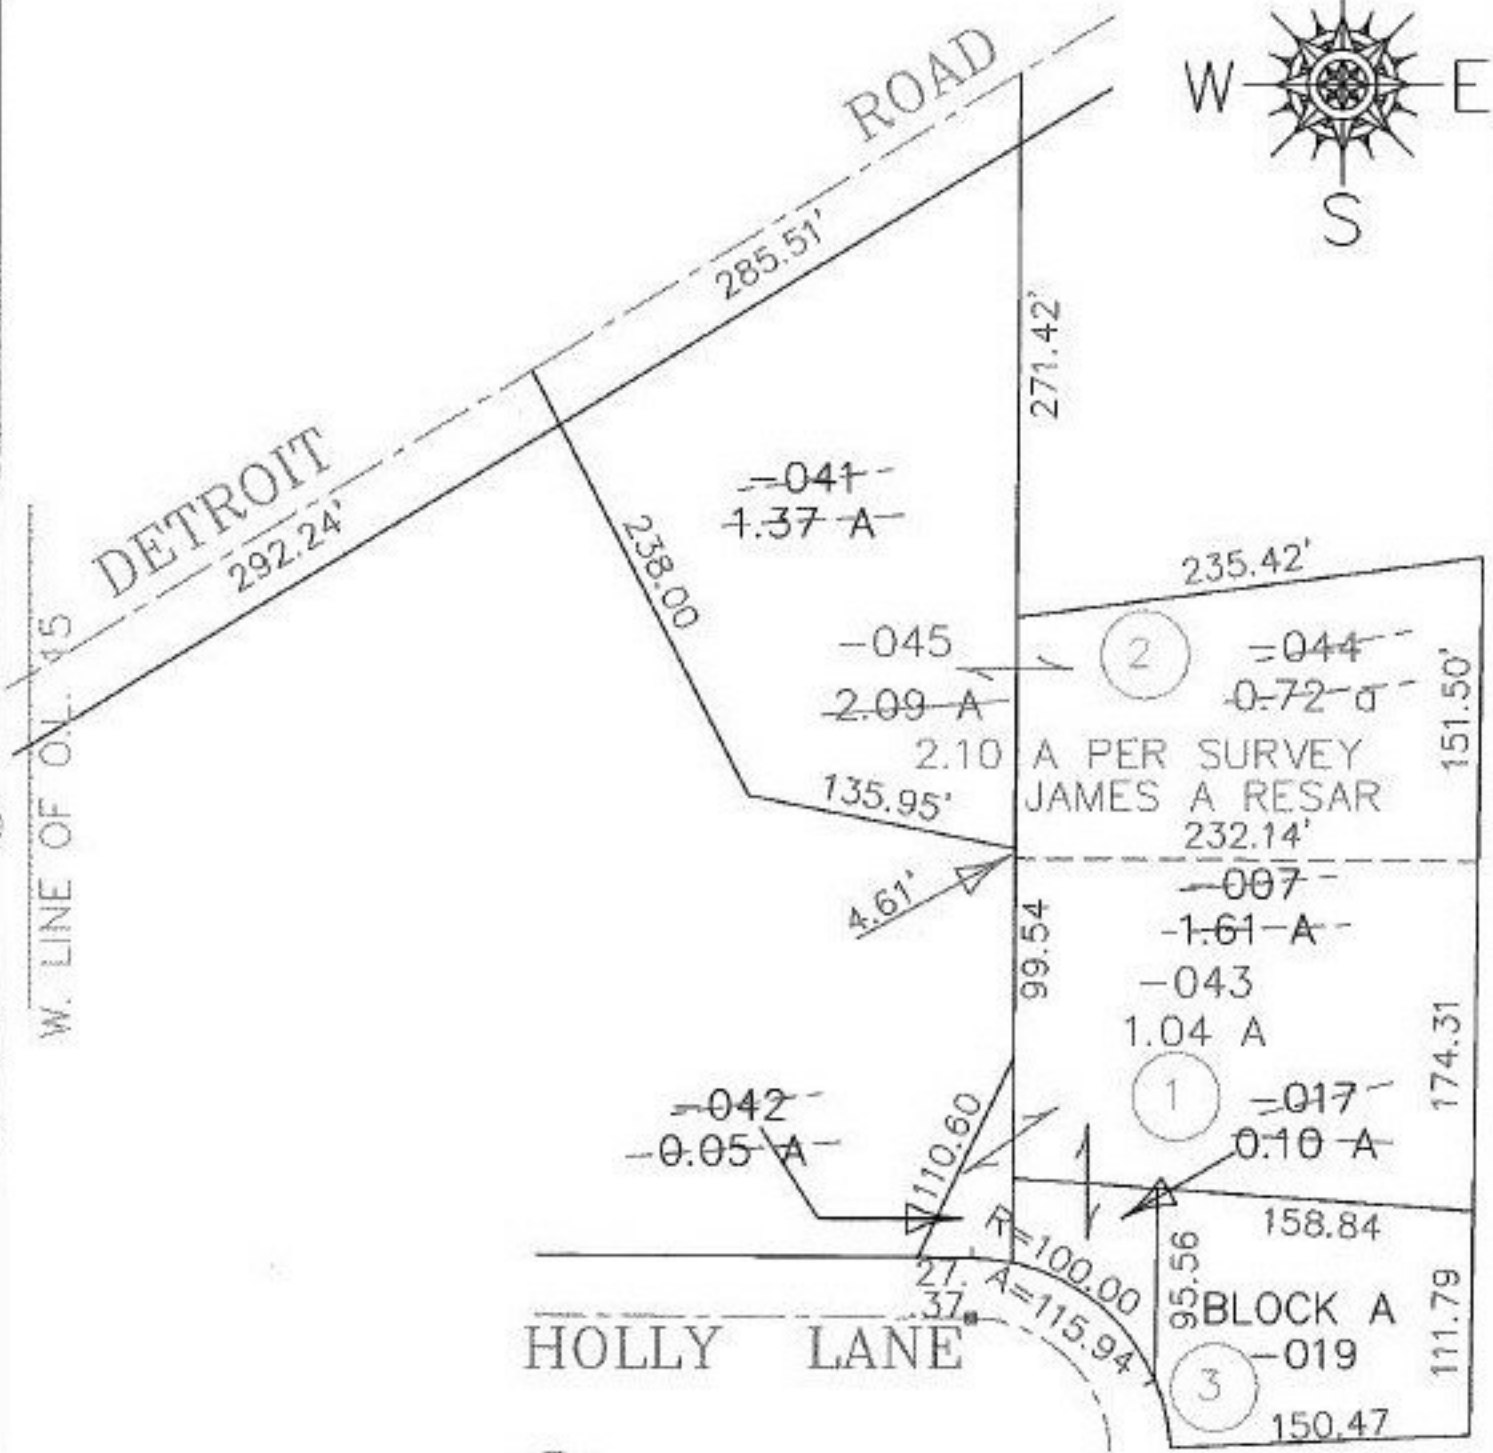

SPLITS/DEEDS PROCESSED
 LORAIN COUNTY TAX MAP DEPARTMENT
 226 MIDDLE AVE. ELYRIA, OHIO

SURVEYED BY: JAMES A RESAR
 CLOSURE: 0.04 / 10.000
 MAP PAGE(S): 4-00-015-F
 APPROVED BY: F. COLBERT DATE: 9/9/98
 SCALE: 1" = 100' PRIOR INSTRUMENT: 100/200