


PARENT PARCEL: 21-05-020-000-019

CHILD PARCEL: 21-05-020-000-020 & 021

STARTING POINT: I.P. IN CL. OF CLARK RD. & CL. OF BURSLEY RD.

NO. 22589

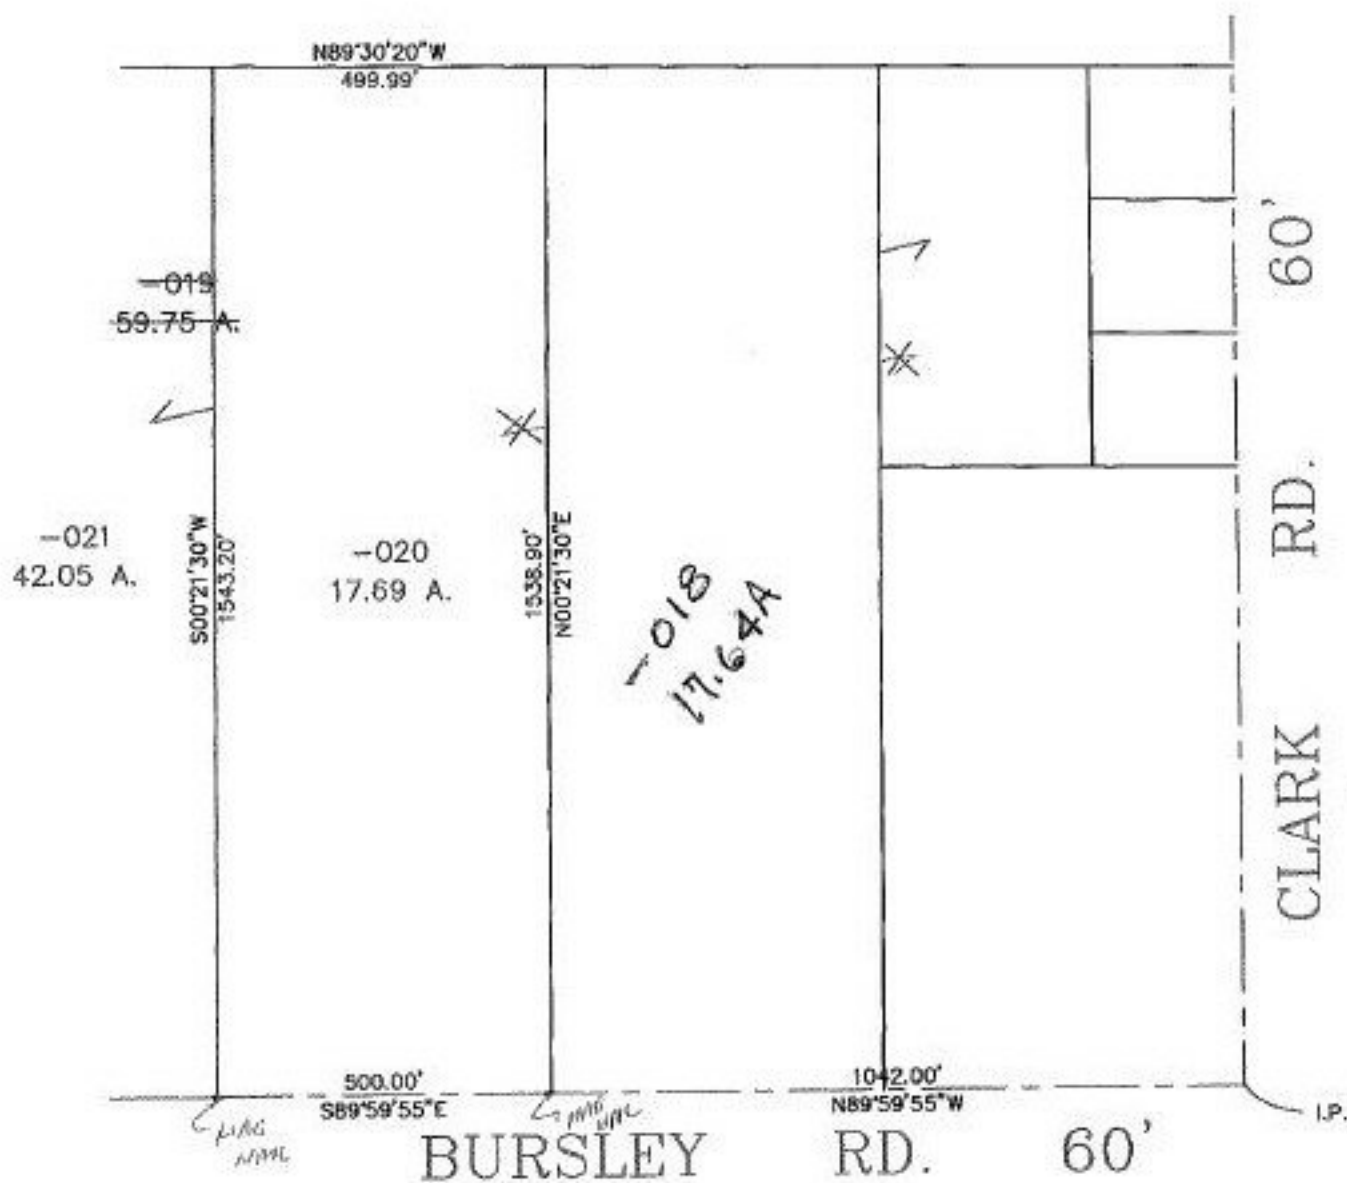

SPLITS/DEEDS PROCESSED
LORAIN COUNTY TAX MAP DEPARTMENT
 226 MIDDLE AVE. ELYRIA, OHIO

SURVEYED BY: THOMAS M. SNEZEK
 CLOSURE: 0.01 : 10.000
 MAP PAGE(S): 21-A
 APPROVED BY: IJS DATE: 07/15/98
 SCALE: 1" = 300' PRIOR INSTRUMENT: DV 1372/258