
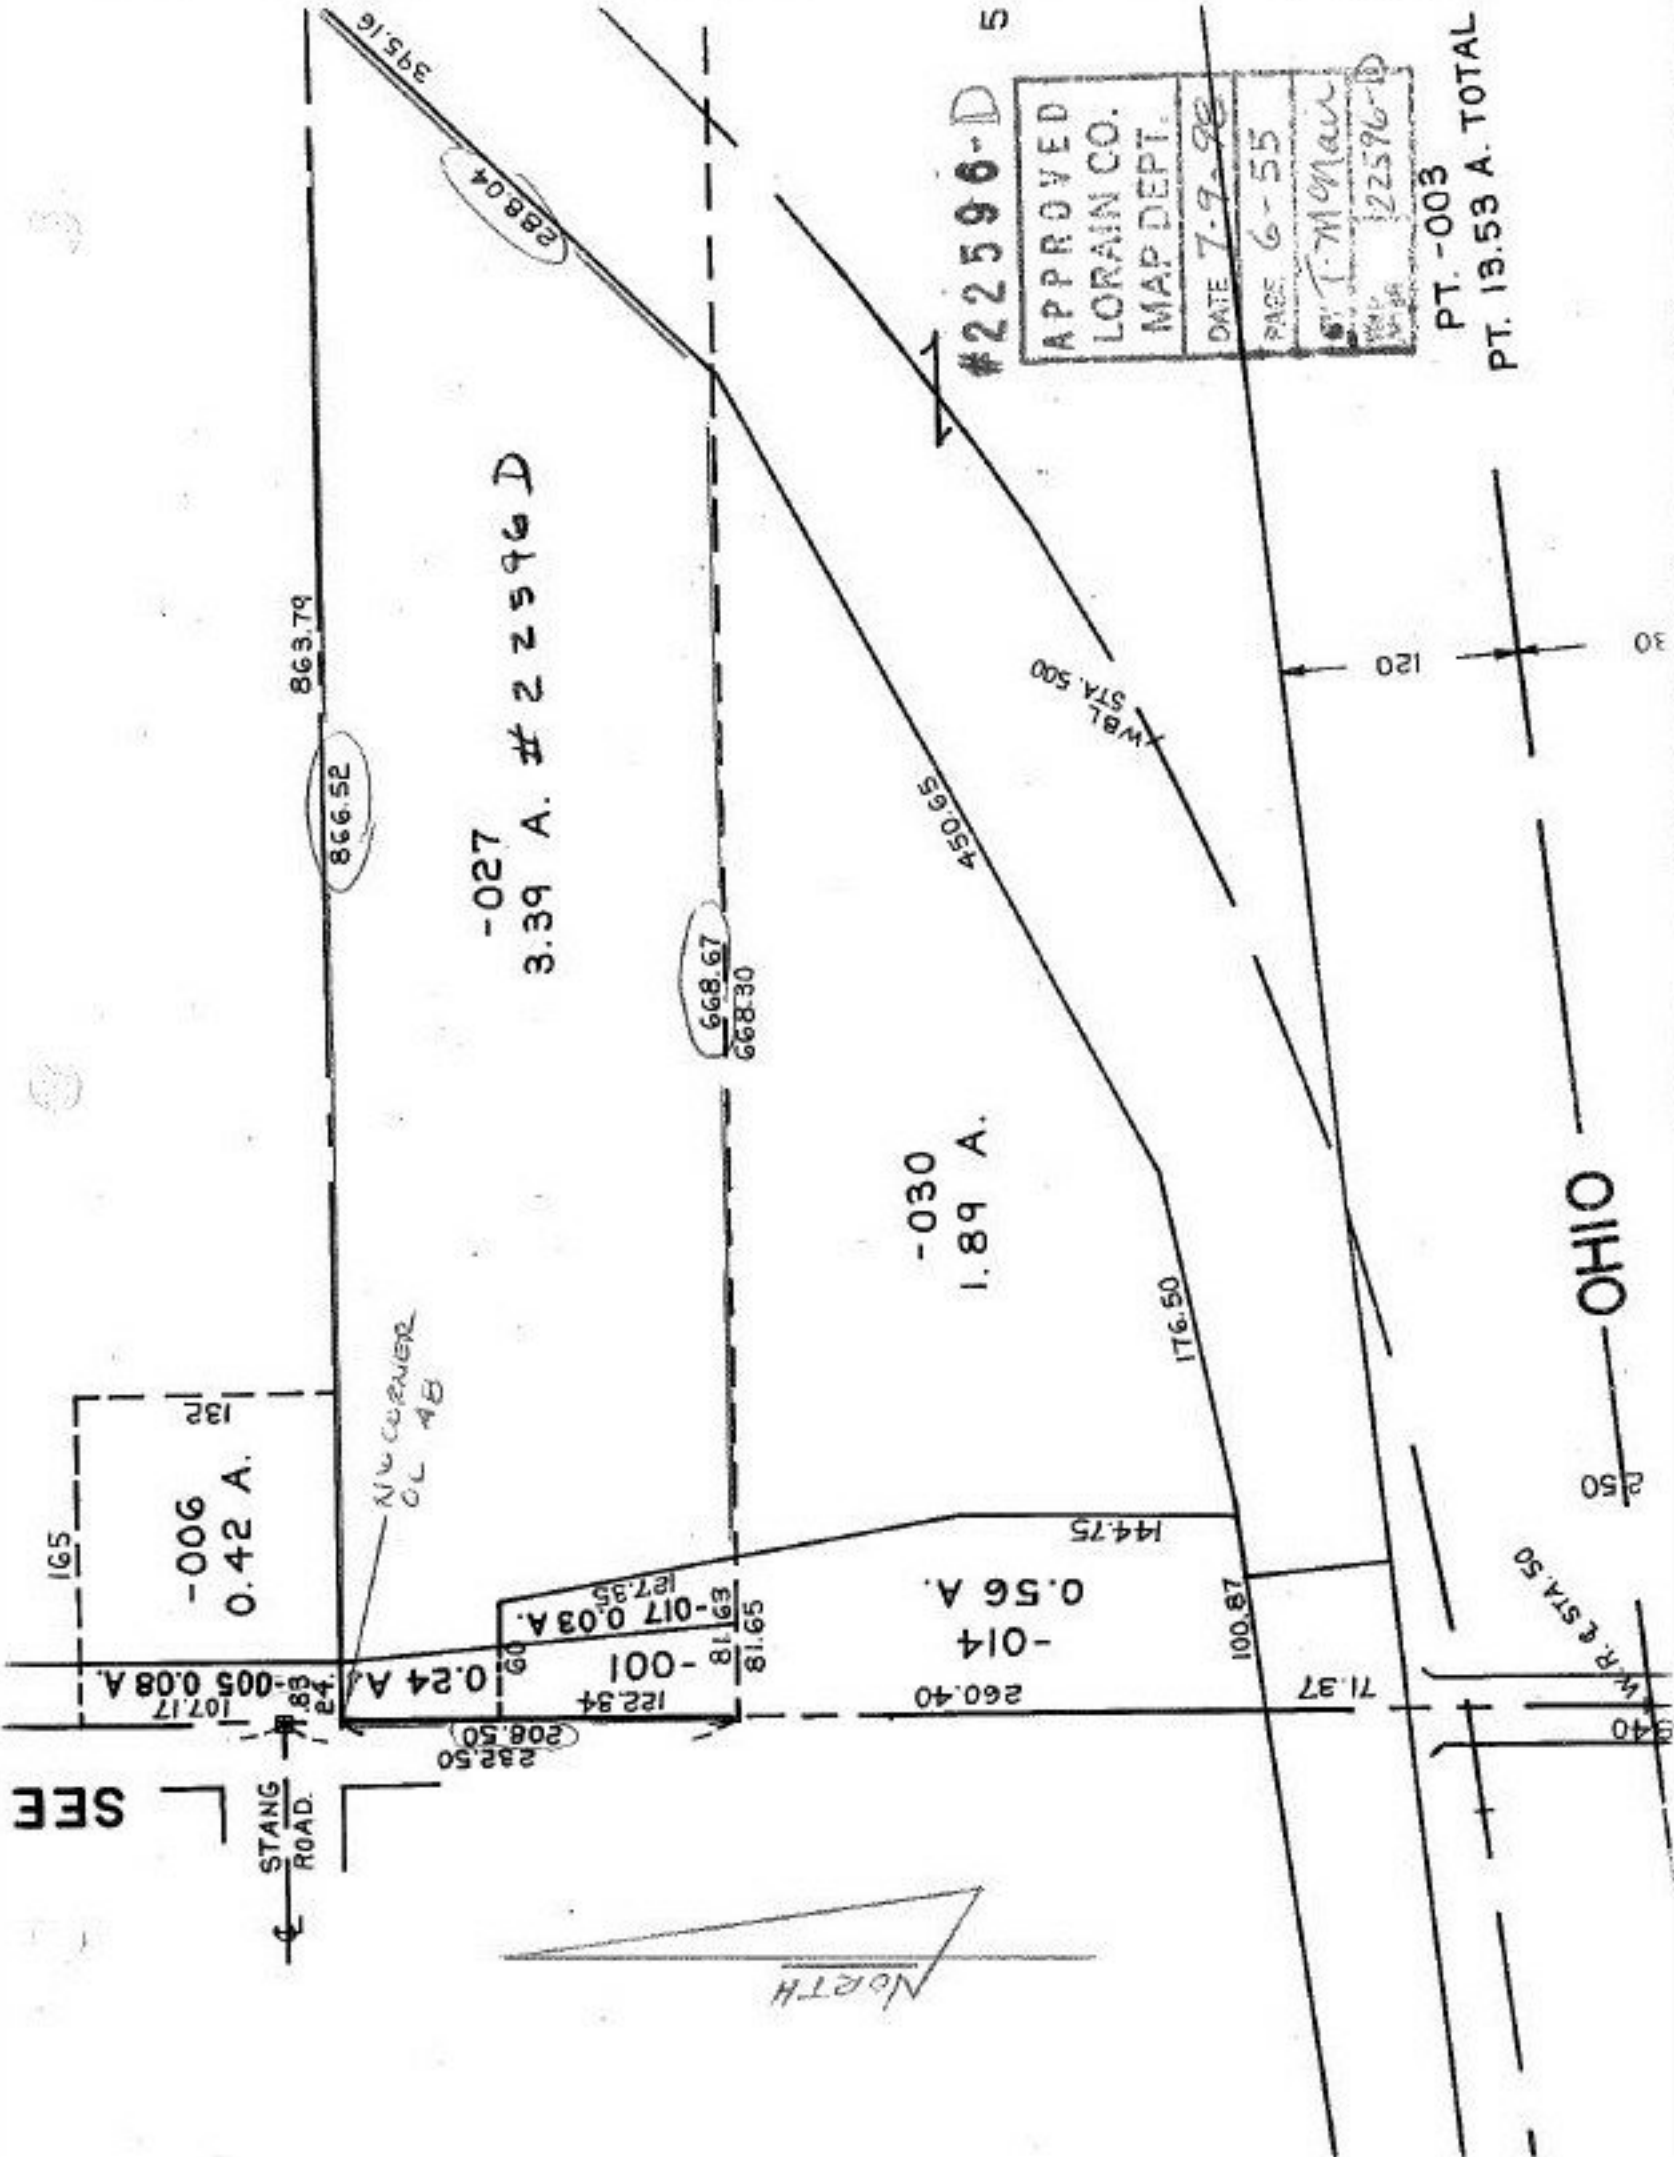


SFE

STANG ROAD

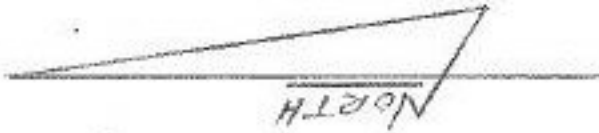

-006
0.42 A.

NO CORNER
OL AB

0.24 A.
-001
-017 0.03 A.

-014
0.56 A.

-030
1.89 A.

-027
3.39 A. #22596D

#22596-D
5

APPROVED
LORAIN CO.
MAP DEPT.
DATE 7-9-98
PAGE 6-55
T. McMan
22596-D

PT. -003
PT. 13.53 A. TOTAL

OHIO

W.R. & STA. 50