

SEE 9-00-085-B

PARCEL SIZE CORR.
PER KS SURVEY

22599-D


APPROVED
LORAIN CO.
MAP DEPT.

DATE 7/17/98

PAGE 9-00-086-A

BY TJS

22599-D

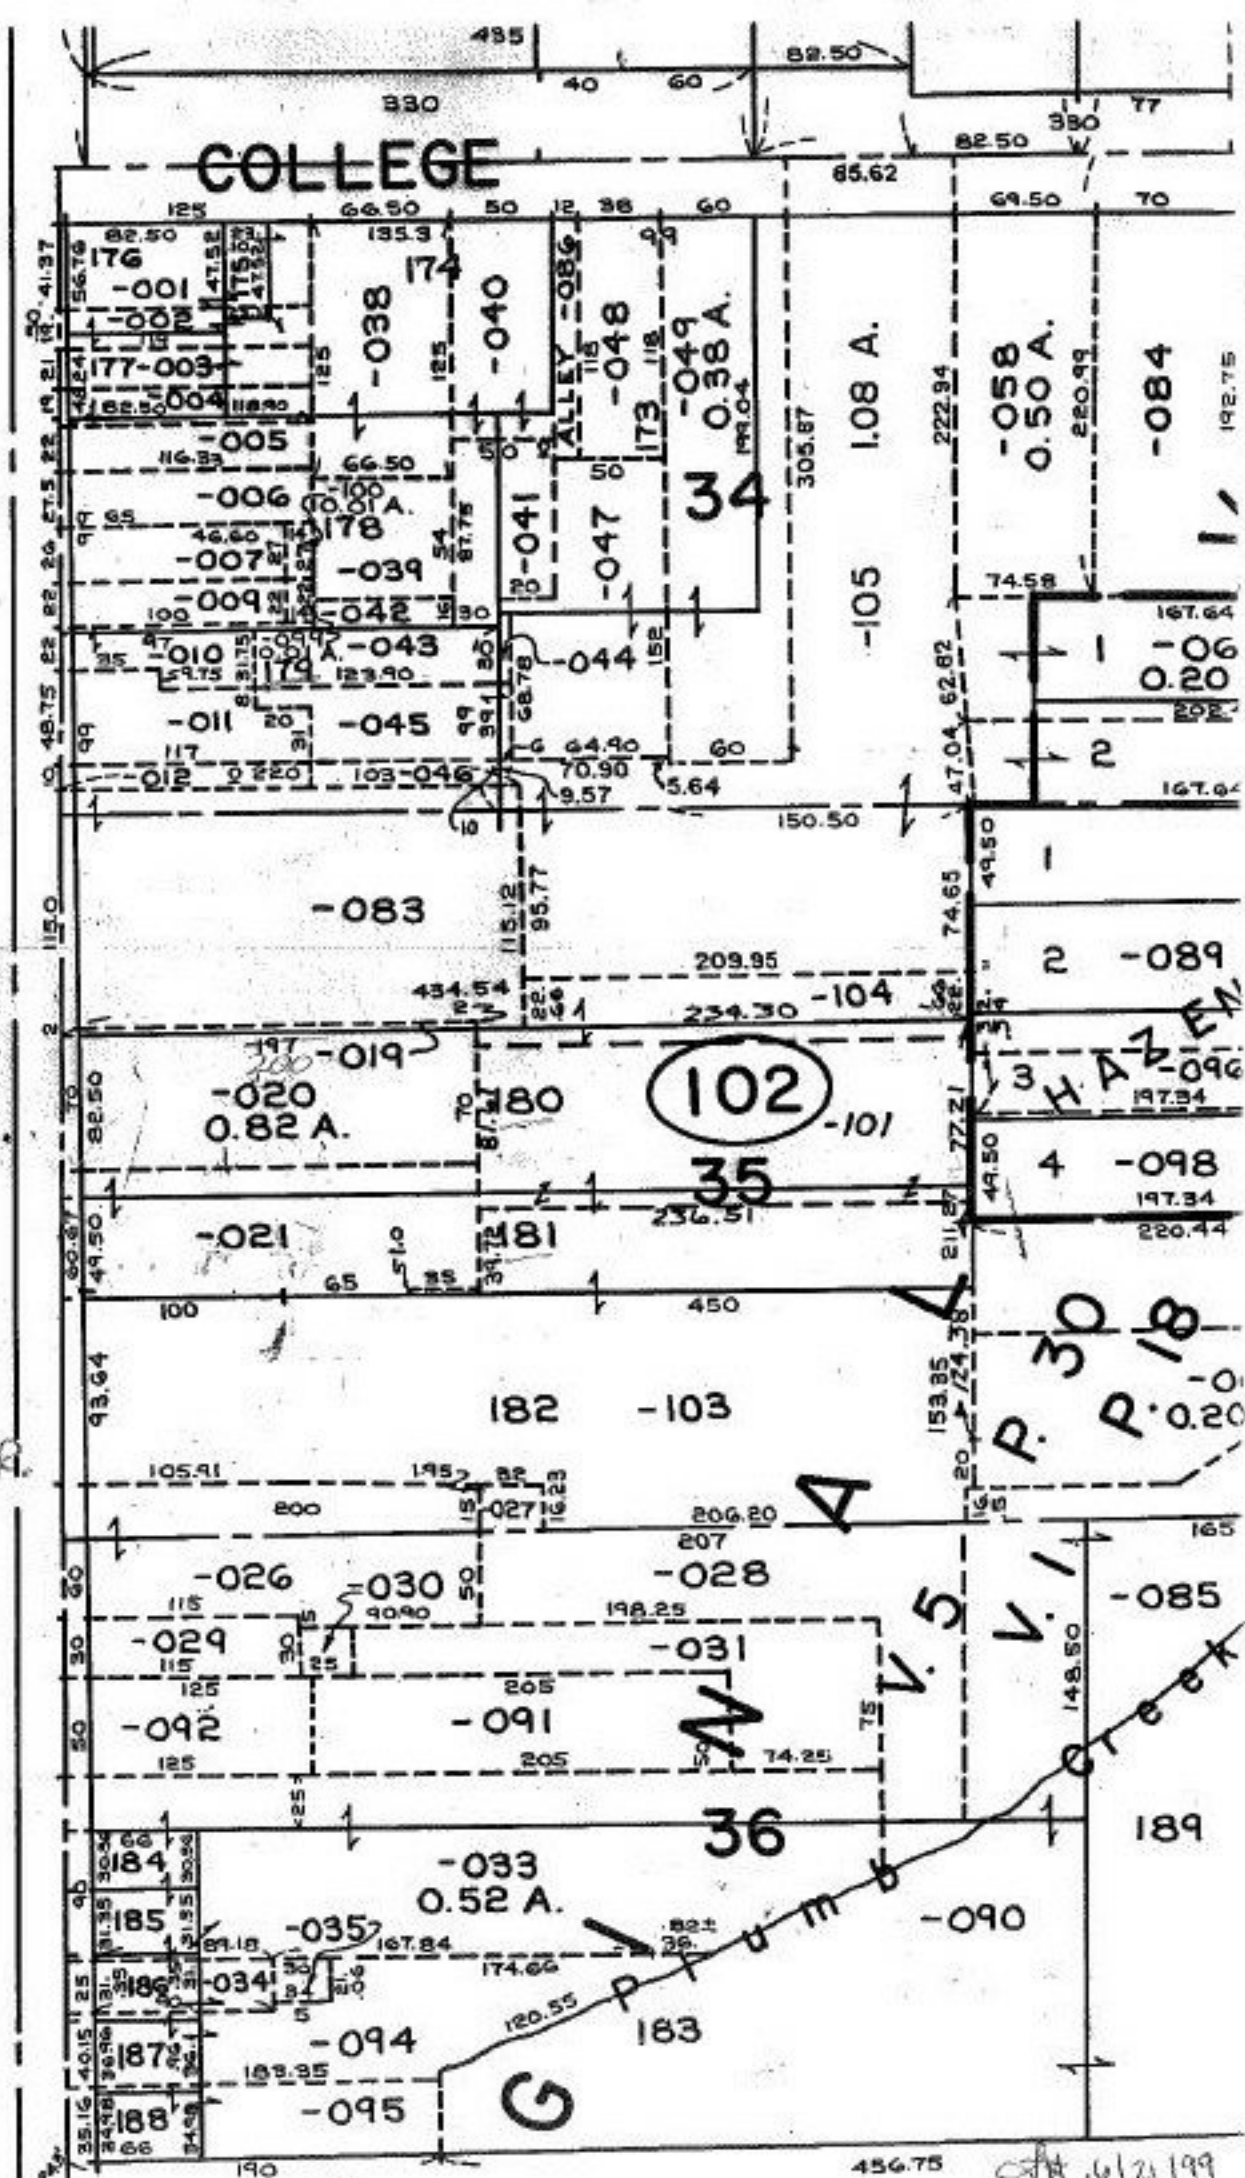

456.75 6/21/99