

PARENT PARCEL: 07-00-020-109-025
CHILD PARCEL: XX-XX-XXX-XXX-XXX
STARTING POINT: FRONTAGE CORRECTION

NO. 22602-A




FRONTAGE CORRECTION

07-00-020-109-025

~~20 X 115~~

24 X 115.44

CORR. PER PLAT V. 10 PG. 22 & 23

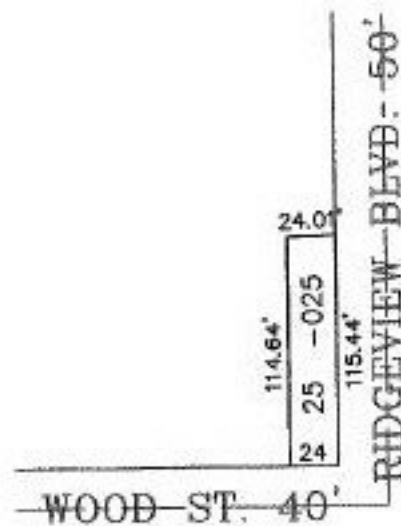

SPLITS/DEEDS PROCESSED
LORAIN COUNTY TAX MAP DEPARTMENT
226 MIDDLE AVE. ELYRIA, OHIO

SURVEYED BY: PLAT V. 10 PG. 22 & 23
CLOSURE: CAN'T RUN
MAP PAGE(S): 07-00-020-B
APPROVED BY: TJS DATE: 07/27/98
SCALE: 1" = 100' PRIOR INSTRUMENT: