
PARENT PARCEL: 03-00-044-103-030

STARTING POINT:__

CHILD PARCEL: PUT ON MAP WRONG, -031, SHOULD HAVE BEEN -030

NO. 22605-X

MAP CORRECTION ONLY

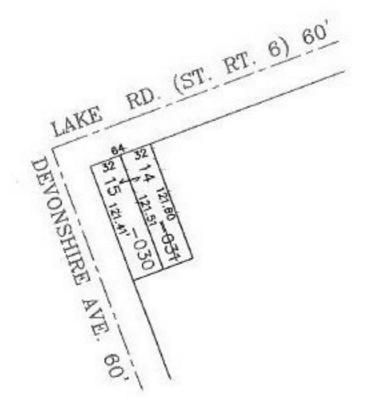

SPLITS/DEEDS PROCESSED LORAIN COUNTY TAX MAP DEPARTMENT 226 MIDDLE AVE. ELYRIA, OHIO

SURVEYED BY: TAX MAP

CLOSURE: CAN'T RUN

MAP PAGE(S): 03-00-044

07/30/98 APPROVED BY: TJS DATE:

SCALE: 1"= 100 PRIOR INSTRUMENT: NONE