

PARENT PARCEL: 01-00-006-102-031


CHILD PARCEL: 01-00-006-102-040 & 041

STARTING POINT: IRON PIPE IN THE S.E. CORNER OF O.L. 6


NO. 22605



LIBERTY AVE. (U.S. 6)

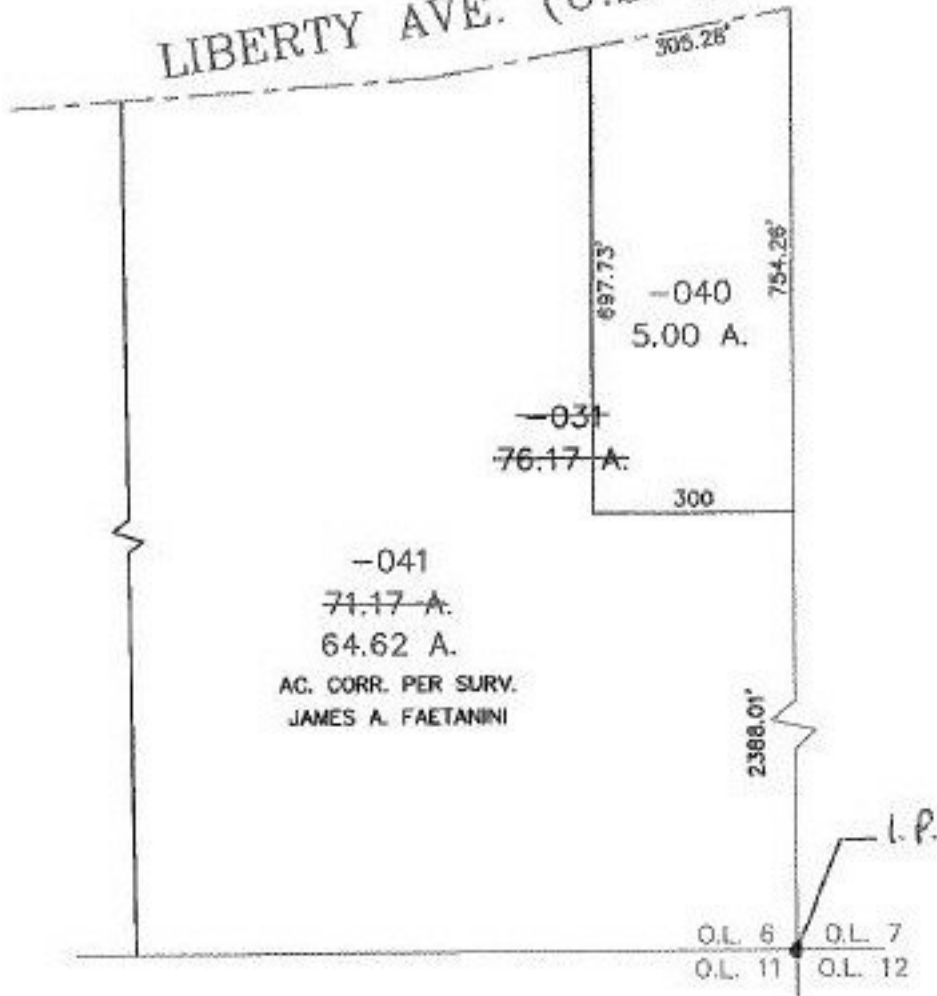

FS
2-19-99

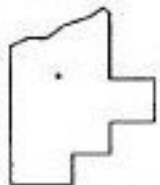

SPLITS/DEEDS PROCESSED
LORAIN COUNTY TAX MAP DEPARTMENT
226 MIDDLE AVE. ELYRIA, OHIO

SURVEYED BY: JAMES A. FAETANINI
 CLOSURE: 0.05 : 10.000
 MAP PAGE(S): 1-C
 APPROVED BY: TJS DATE: 07/29/98
 SCALE: 1" = 300 PRIOR INSTRUMENT: OR 265/555