

PARENT PARCEL: 05-00-016-102-016

CHILD PARCEL: XX-XX-XXX-XXX-XXX

STARTING POINT: CL OF PYLE S. AMHERST RD. & S.W. CORNER OF LAND CONVEYED TO CHARLES KREIG

NO. 22608-D


DEED CHECK

05-00-016-102-016


DEED IS NOT A GOOD DESCRIPTION.

MUST GET A SURVEY

7/21/98 980551232

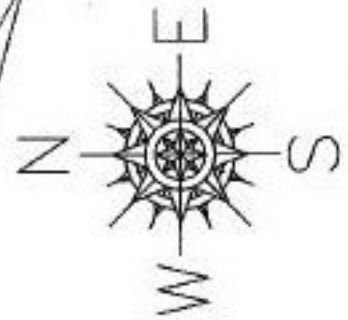

MAP CHANGE

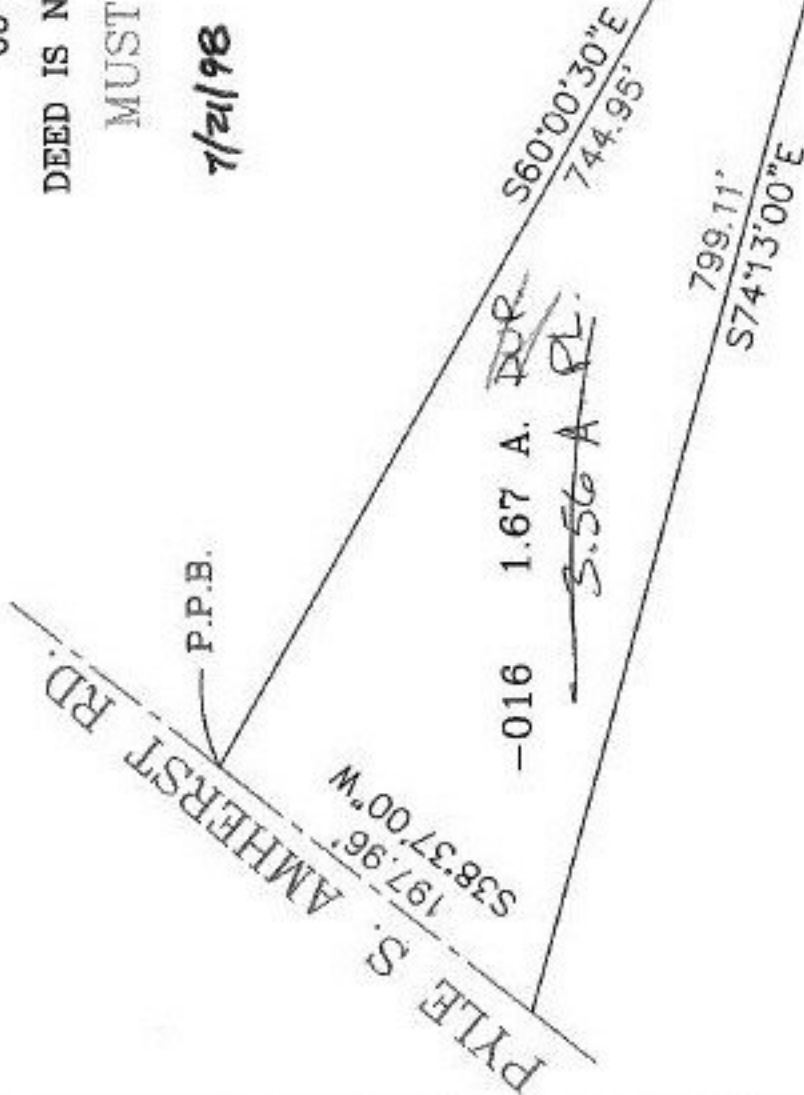

SPLITS/DEEDS PROCESSED
LORAIN COUNTY TAX MAP DEPARTMENT
226 MIDDLE AVE. ELYRIA, OHIO

SURVEYED BY: DEED
 CLOSURE: 2.41 : 10,000
 MAP PAGE(S): 05-00-016-B
 APPROVED BY: TJS DATE: 07/17/98
 SCALE: 1" = 100' PRIOR INSTRUMENT: DV 550/114