


PARENT PARCEL: 06-24-026-119-014 & 015

CHILD PARCEL: XX-XX-XXX-XXX-XXX

STARTING POINT: I.P. FOUND AT THE INTERSECTION OF TH S.W. SIDELINE OF LAKE AVE. & THE LINE BETWEEN S\ 106 & 107

NO. 22609-D

SCALE: 1" = 50'

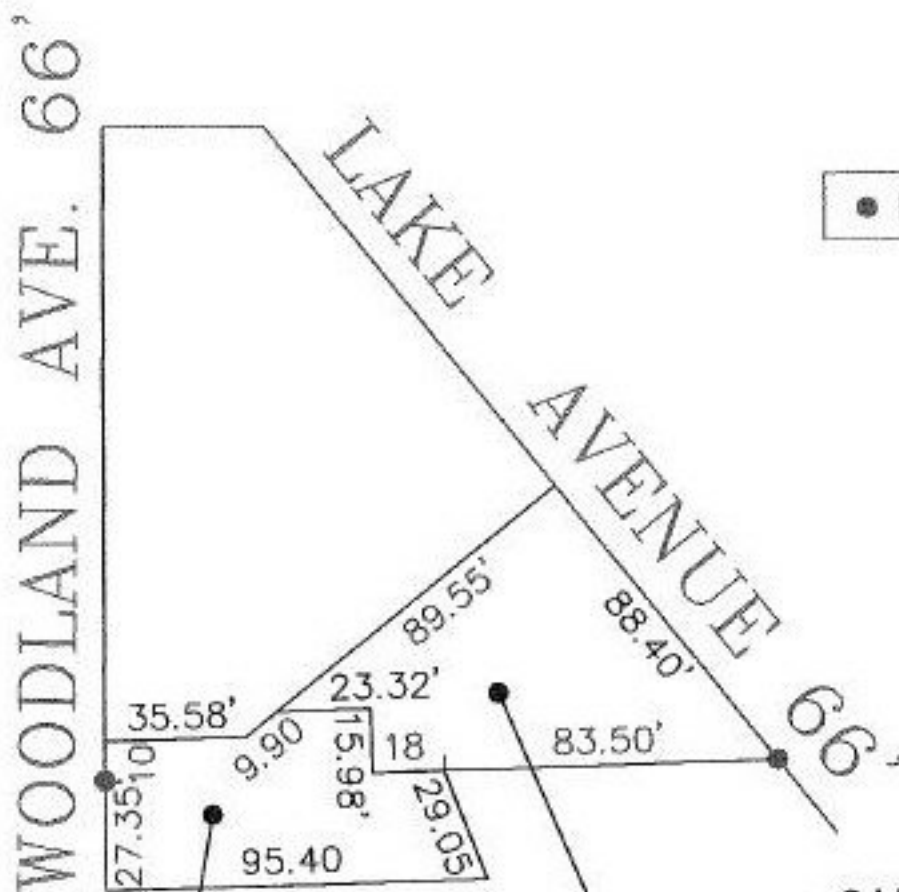

● I.P.

-014
37.35 X 95.40

-015
~~88.40 X 105.60~~
88.40 X 89.55
AC. CORR. PER SURV.
KS & ASSOC.



SPLITS/DEEDS PROCESSED
LORAIN COUNTY TAX MAP DEPARTMENT
226 MIDDLE AVE. ELYRIA, OHIO

SURVEYED BY: KS & ASSOC.
CLOSURE: 0.21 : 10,000
MAP PAGE(S): 6-79
APPROVED BY: TJS DATE: 07/17/98
SCALE: 1" = 50' PRIOR INSTRUMENT: DV 926/179