


PARENT PARCEL: 08-00-091-000-014

CHILD PARCEL: 08-00-091-000-059 & 060

STARTING POINT: CL OF GIFFORD RD. & CL OF MILAN - ELYRIA RD.

NO. 22611

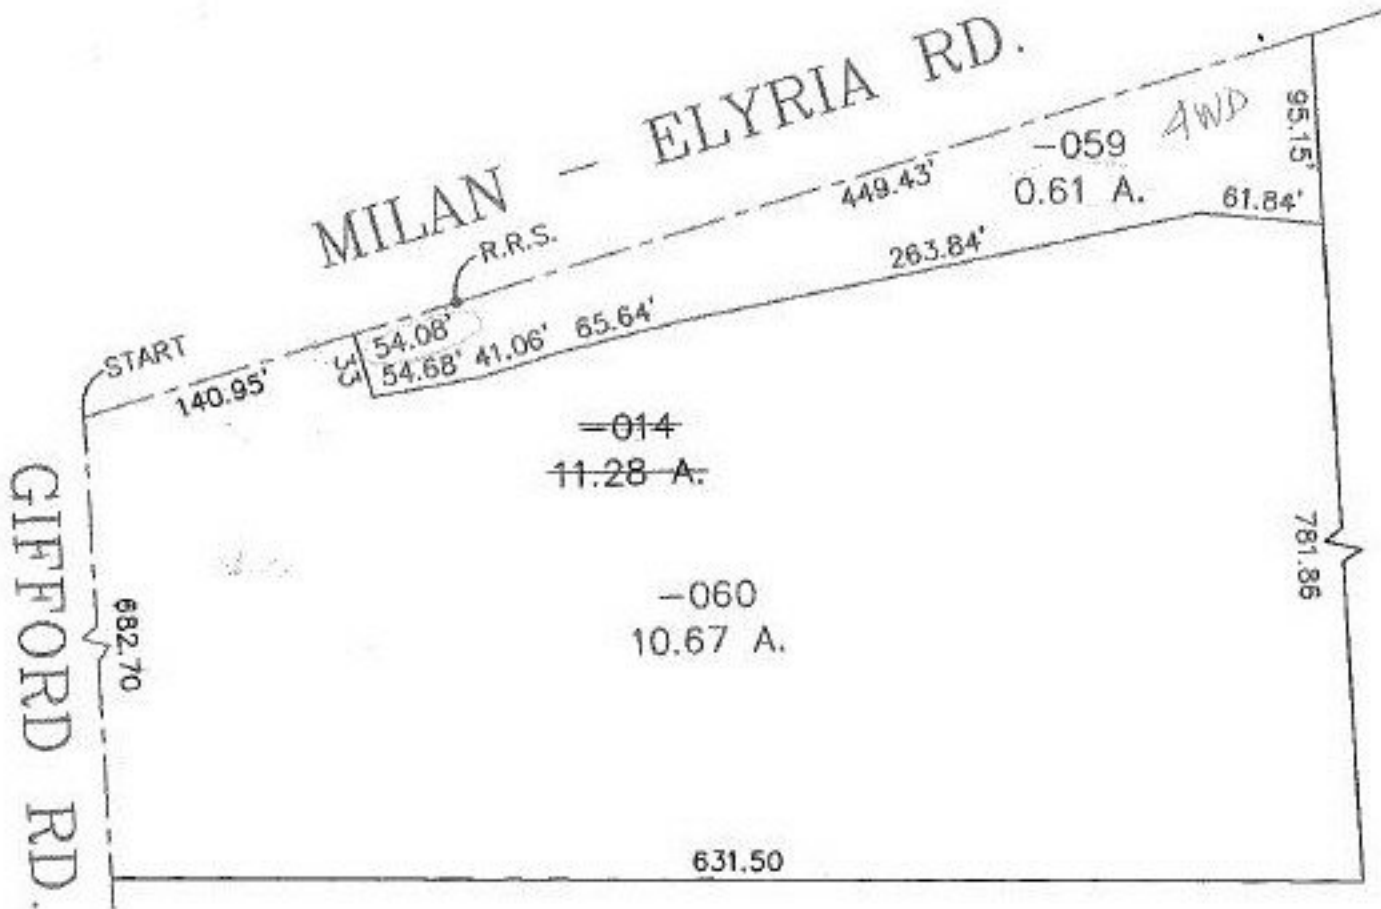

Drawn to D.M.L. Below



SPLITS/DEEDS PROCESSED
 LORAIN COUNTY TAX MAP DEPARTMENT
 226 MIDDLE AVE. ELYRIA, OHIO

SURVEYED BY: RONALD D. ROBINSON

CLOSURE: 0.03 : 10,000

MAP PAGE(S): B-C

APPROVED BY: TJS DATE: 08/05/98

SCALE: 1" = 100' PRIOR INSTRUMENT: DV 1205/609