

PARENT PARCEL: 04-00-007-150-015


CHILD PARCEL: 04-00-007-150-085 & -086

STARTING POINT: I.P. MON. IN THE CL OF WALKER RD. & S.E. CORNER OF O.L. 7

NO. 22615



AC. CORR. PER SURV.
DONALD E. WOIKE

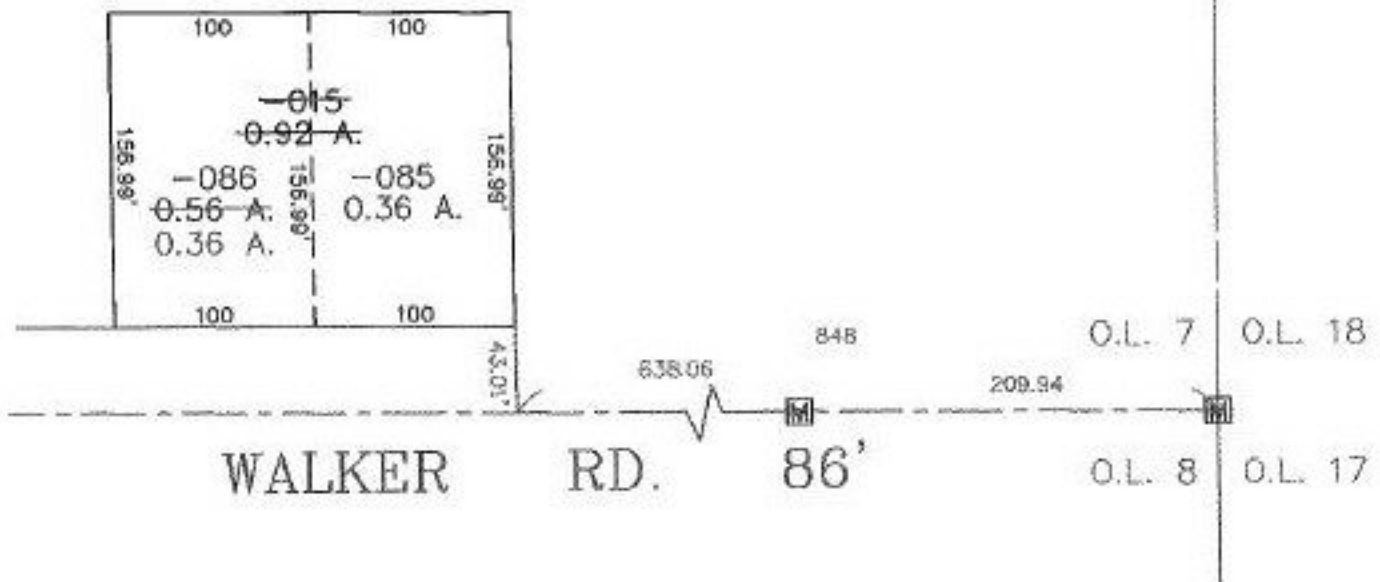

23
2-4-99



SPLITS/DEEDS PROCESSED
LORAIN COUNTY TAX MAP DEPARTMENT
226 MIDDLE AVE. ELYRIA, OHIO

SURVEYED BY:	DONALD E. WOIKE
CLOSURE:	0.00 : 10.000
MAP PAGE(S):	04-00-007-11
APPROVED BY:	TJS DATE: 09/24/98
SCALE:	1" = 100. PRIOR INSTRUMENT: OR 25/283