

PARENT PARCEL: 05-00-097-101-003


CHILD PARCEL: 05-00-097-101-029 & 030

STARTING POINT: L.P., AT CL OF CROSSE RD. & CL OF N. RIDGE RD.

NO. 22617



CROSSE RD. 60' S
L.P.

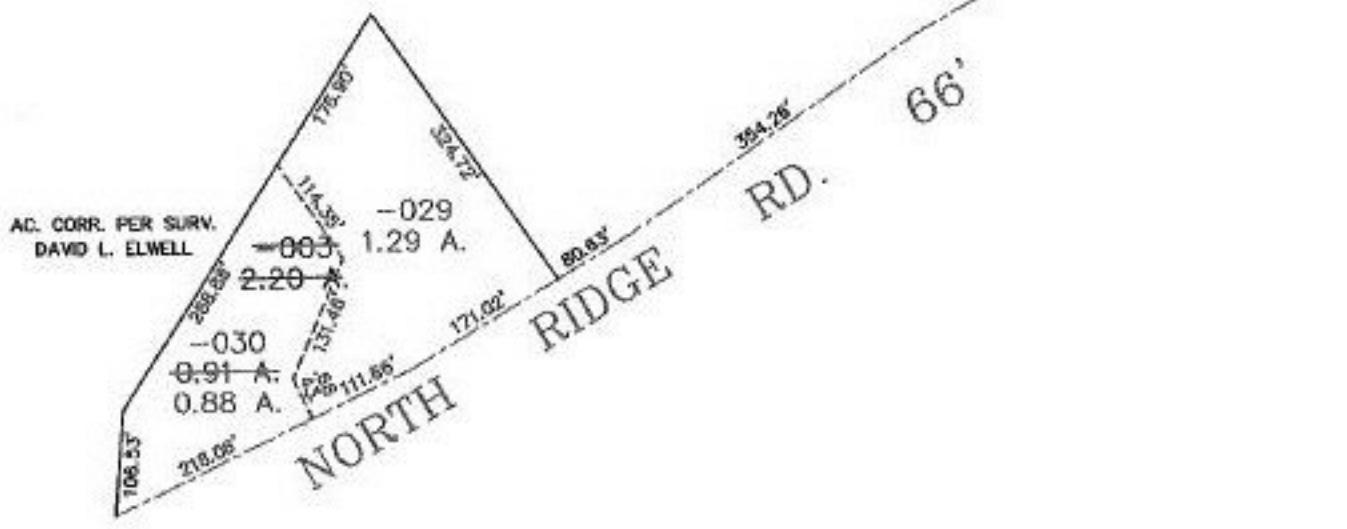

SPLITS/DEEDS PROCESSED
 LORAIN COUNTY TAX MAP DEPARTMENT
 226 MIDDLE AVE. ELYRIA, OHIO

SURVEYED BY: DAVID L. ELWELL
 CLOSURE: 0.06 : 10,000
 MAP PAGE(S): 05-00-097-A
 APPROVED BY: TJS DATE: 08/17/98
 SCALE: 1" = 200' PRIOR INSTRUMENT: 970484708