


WHEELER & MITCHELL
V. 1 P. 27

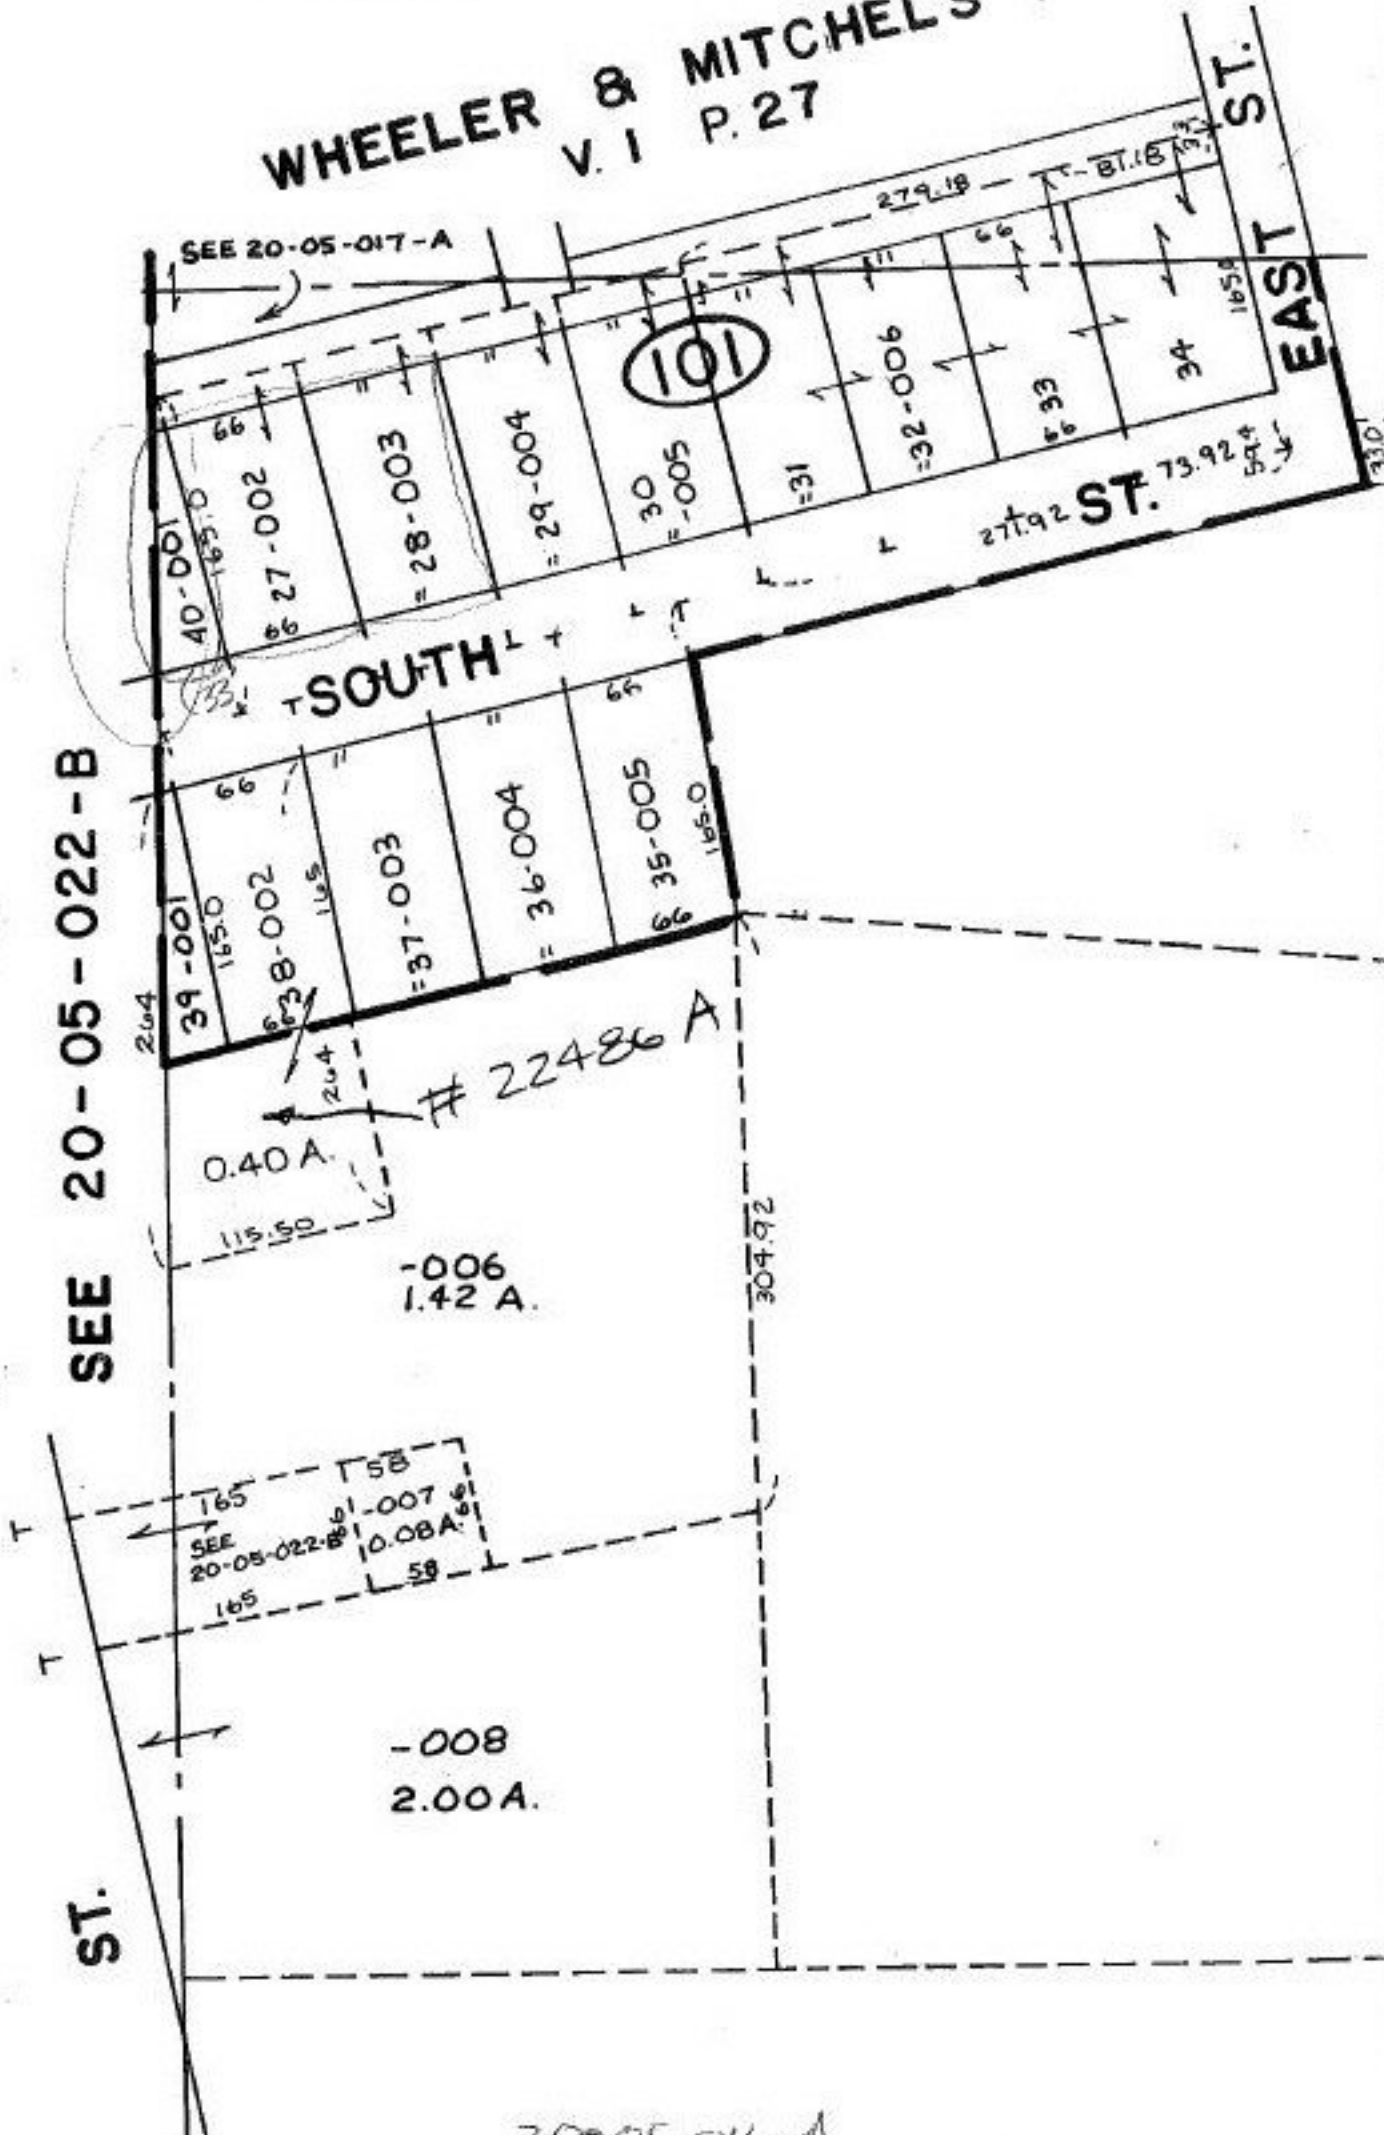

SEE 20-05-022-B

SEE 20-05-017-A

SOUTH

EAST ST.

ST. 73.92

-006
1.42 A.

-008
2.00 A.

SEE 20-05-022-B
0.08 A

22486 A

101

20-05-016-A