


PARENT PARCEL: 12-00-006-102-009

CHILD PARCEL: 12-00-006-102-040, 041

STARTING POINT: MON. BOX AT C/L OF MARKS ROAD & ROYALTON ROAD

NO. 22621

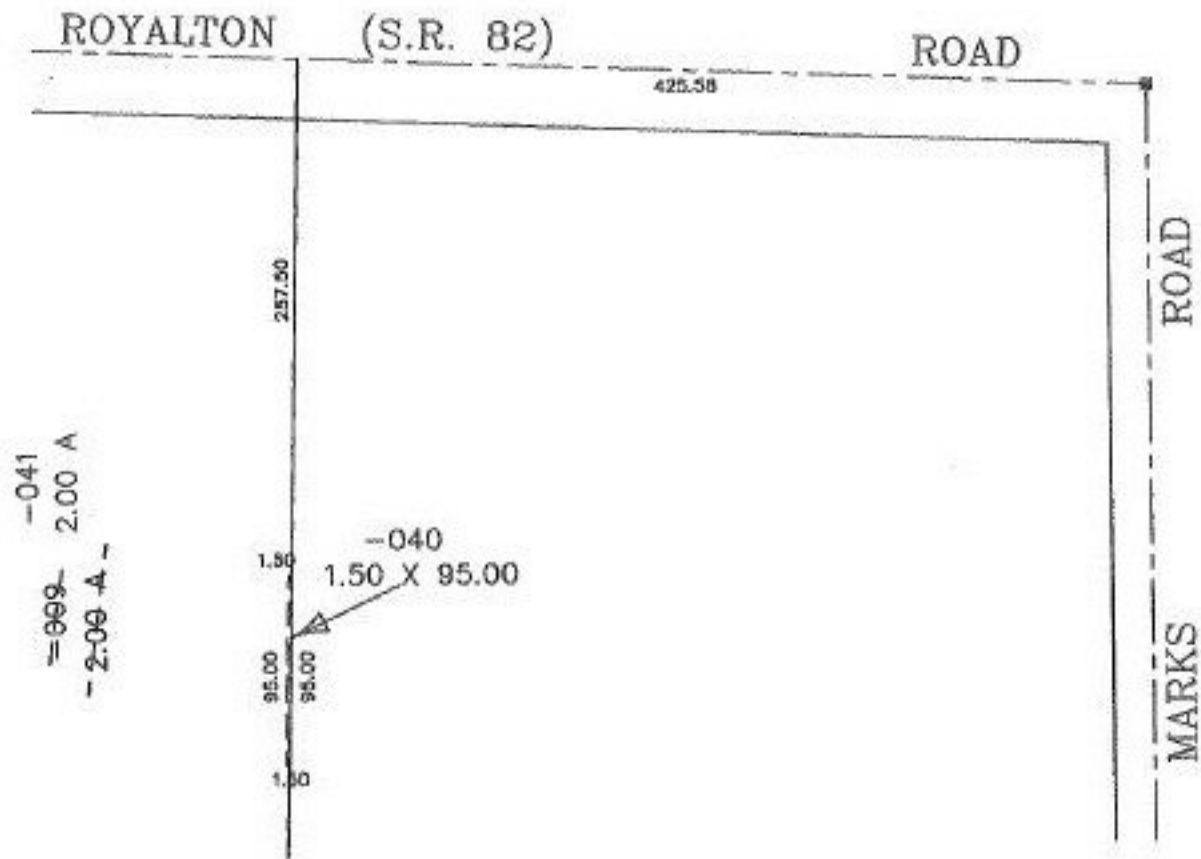

**SPLITS/DEEDS PROCESSED**  
 LORAIN COUNTY TAX MAP DEPARTMENT  
 226 MIDDLE AVE. ELYRIA, OHIO

SURVEYED BY: JAMES B. ROBERTS / 4279  
 CLOSURE: 0.00 PER 10,000  
 MAP PAGE(S): 12-00-006-8  
 APPROVED BY: F. COLBERT DATE: 8/27/98  
 SCALE: 1" = 100' PRIOR INSTRUMENT: DV 966/226