


#22623-X

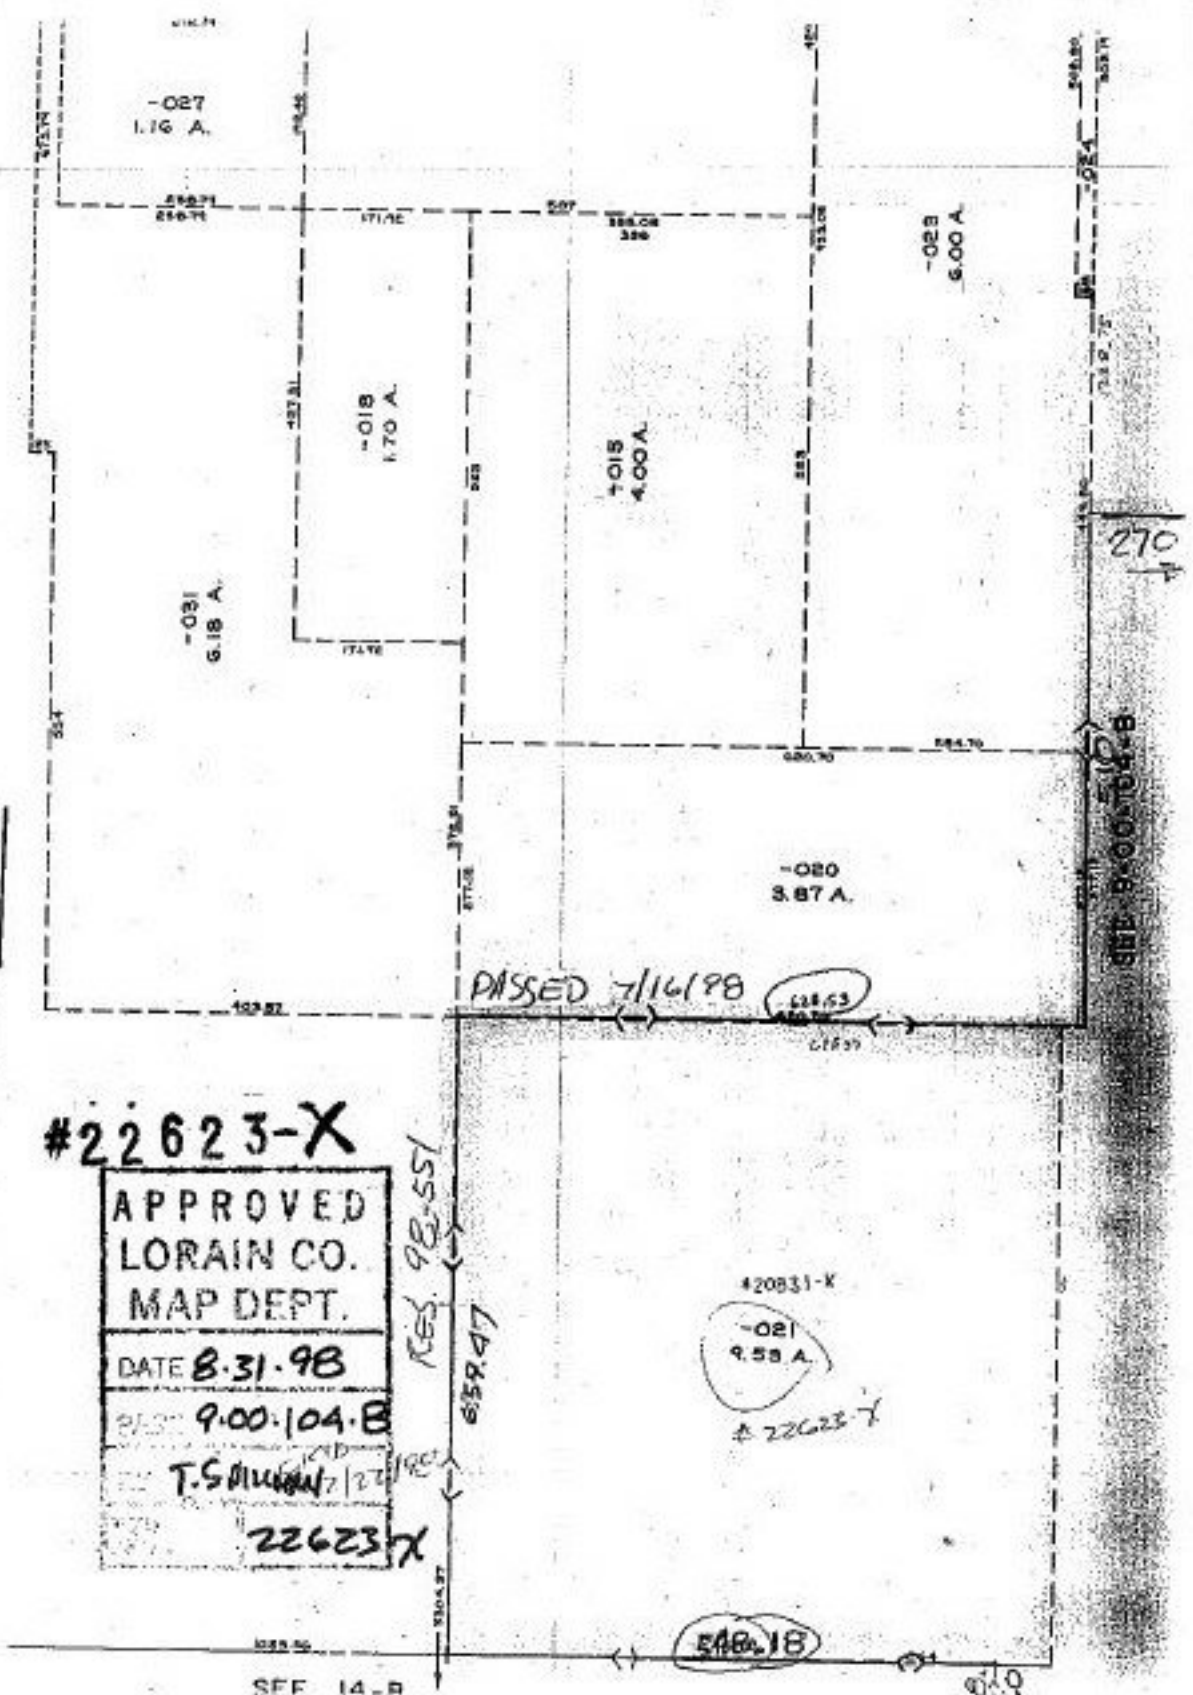

#22623-X

APPROVED
 LORAIN CO.
 MAP DEPT.
 DATE 8.31.98
 9.00.104-B
 T.S. M...
 22623-X

RES. 98-551
658.47

420831-X

-021
9.58 A.

#22623-X

548.18