



#22623-X

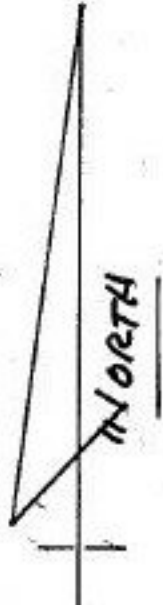

#20831-X
-022
25.08 A
22623-X

(PLEASE A PARCEL WITHIN THIS ANNEXATION)
LAND ANNEXED BY OBERLIN IS ONLY A PART OF -022

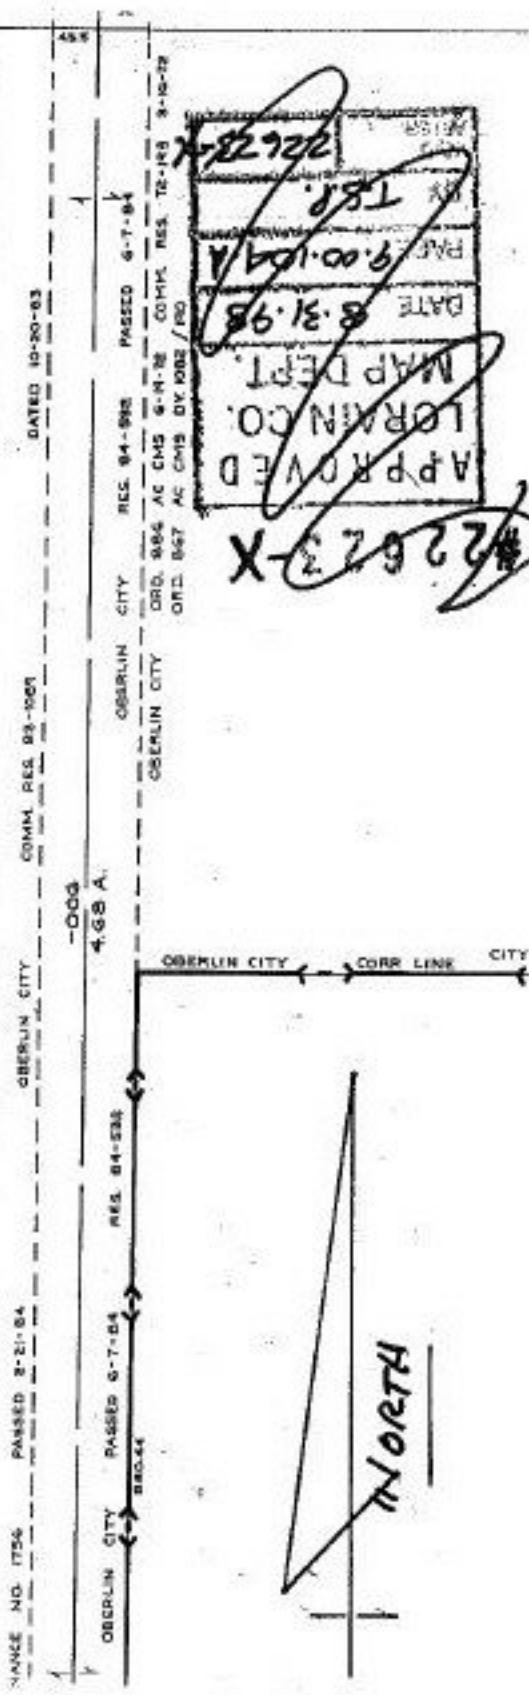

APPROVED
LORAIN CO.
MAP DEPT.
DATE 8-31-98
PAGE 900-104.A
T.S.P.
22623-X

#22623-X

APPROVED
LORAIN CO.
MAP DEPT.
DATE 8-31-98
PAGE 900-104.A
BY T.S.PULMAN
VOID AFTER 22623-X