



PARENT PARCEL: 06-25-007-000-137, 165

CHILD PARCEL: 06-25-007-000-236

STARTING POINT: C/Ls ABBE ROAD & EAST BROAD STREET

NO. 22624

# COMBINATION

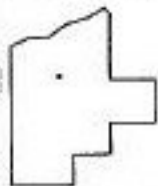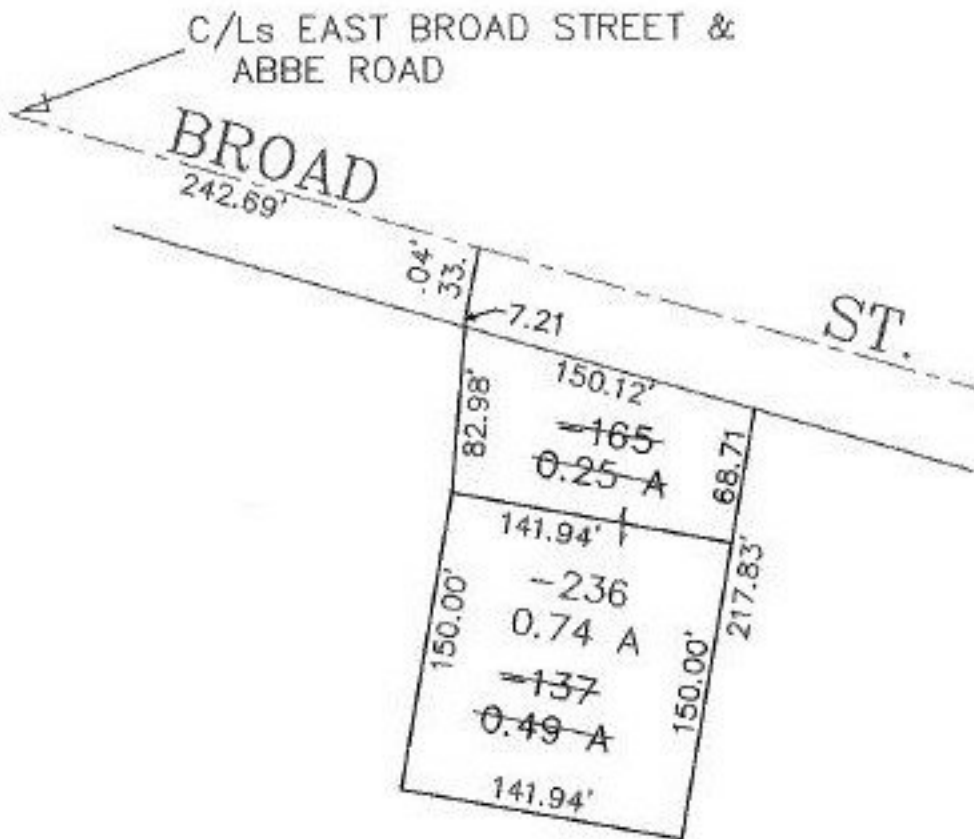

**SPLITS/DEEDS PROCESSED**  
**LORAIN COUNTY TAX MAP DEPARTMENT**  
 226 MIDDLE AVE. ELYRIA, OHIO

SURVEYED BY: DAVID I. ELWELL  
 CLOSURE: 0.05 PER 10,000  
 MAP PAGE(S): 6-125  
 APPROVED BY: F. COLBERT DATE: 8/28/98  
 SCALE: 1" = 100' PRIOR INSTRUMENT: IN970492628