
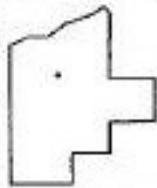


PARENT PARCEL: 05-00-026-102-051 & -054
CHILD PARCEL: 05-00-026-102-055 THRU -057
STARTING POINT: CL OF PLAZA DR. & CL OF MIDDLE RIDGE RD.

NO. 22625

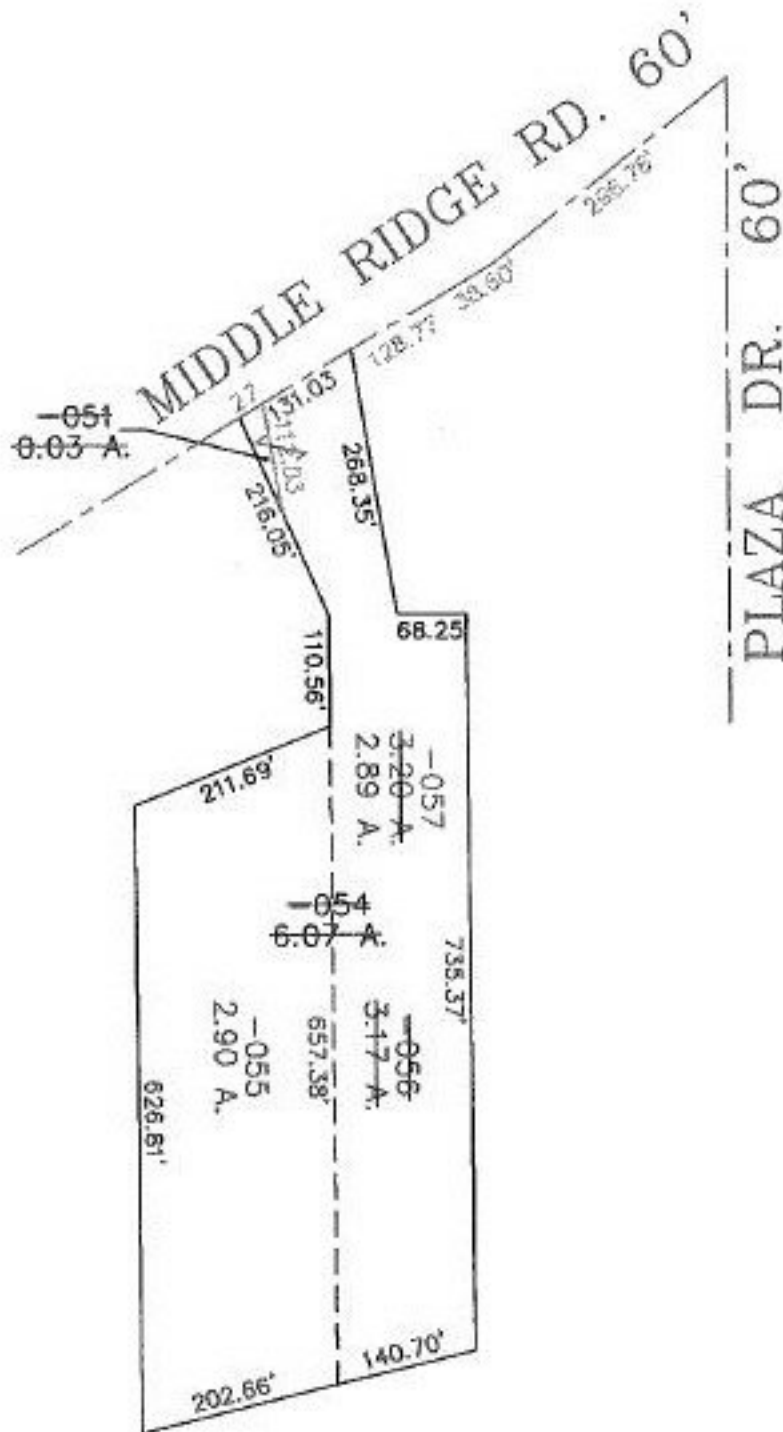

SPLITS/DEEDS PROCESSED
LORAIN COUNTY TAX MAP DEPARTMENT
226 MIDDLE AVE. ELYRIA, OHIO

SURVEYED BY: DAVID L. ELWELL
CLOSURE: 0.02 : 10,000
MAP PAGE(S): 05-00-026-B
APPROVED BY: TJS DATE: 08/28/98
SCALE: 1" = 200' PRIOR INST.: OR 701/163