


PARENT PARCEL: 01-00-033-000-040


CHILD PARCEL: 01-00-033-000-049 & -050

STARTING POINT: CL OF DARROW RD. & EAST LINE OF O.L. 33

NO. 22634

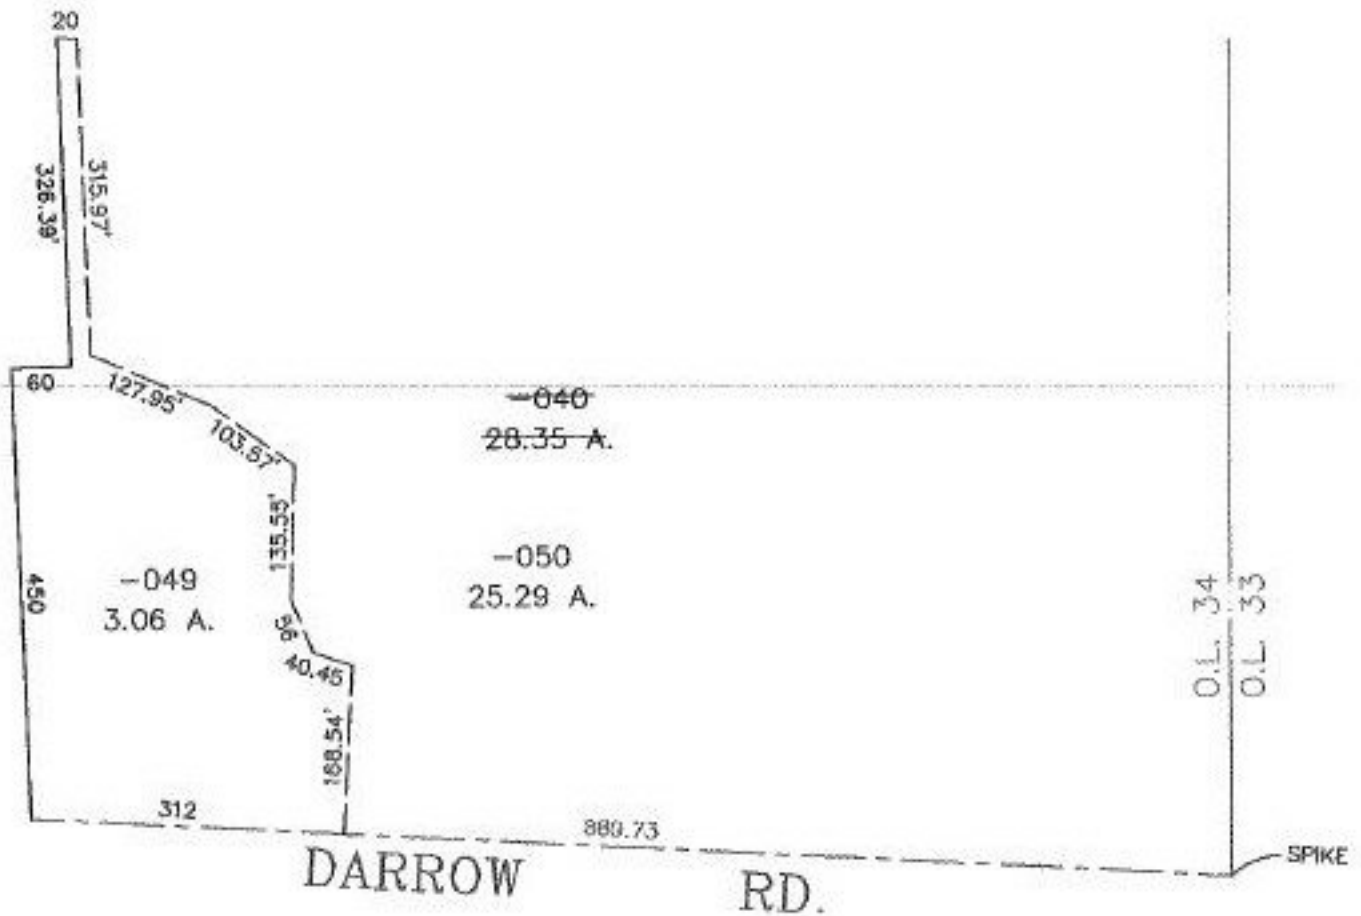

FS
2-19-99

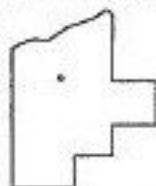

SPLITS/DEEDS PROCESSED
LORAIN COUNTY TAX MAP DEPARTMENT
226 MIDDLE AVE. ELYRIA, OHIO

SURVEYED BY: M. G. HURA
CLOSURE: 0.02 : 10,000
MAP PAGE(S): 1-E
APPROVED BY: TJS DATE: 09/29/98
SCALE: 1" = 200' PRIOR INSTRUMENT: DV 1199/243