

PARENT PARCEL: 02-00-093-116-044 & -048

CHILD PARCEL: 02-00-093-116-050

STARTING POINT: XXXXXX

NO. 22635-X



COMBINATION

~~02-00-093-116-044~~

~~40 x 113~~

&


~~02-00-093-116-048~~

~~40 x 20 TRI.~~

02-00-093-116-050

40 X 113


SCALE: 1"=50'

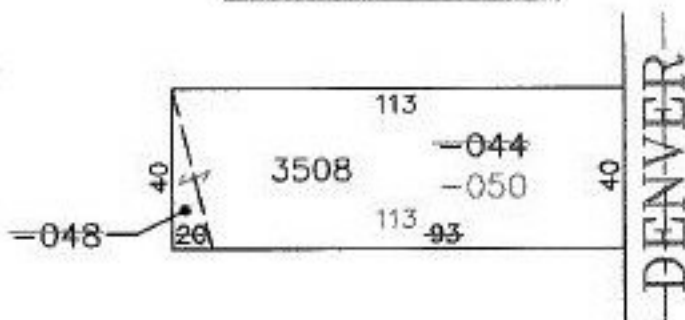

PRIOR INSTRUMENT: DV 961/752

PRIOR INSTRUMENT: OR 338/891

PRIOR INSTRUMENT: OR 742/65

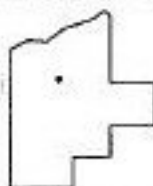

SPLITS/DEEDS PROCESSED
LORAIN COUNTY TAX MAP DEPARTMENT
226 MIDDLE AVE. ELYRIA, OHIO

SURVEYED BY: NONE
CLOSURE: CAN'T RUN
MAP PAGE(S): 02-00-093-B
APPROVED BY: TJS DATE: 09/03/98
SCALE: 1"=100'