


PARENT PARCEL: 16-00-034-000-003, 017

CHILD PARCEL: 16-00-034-000-018, 019, 020, 021, 022

STARTING POINT: MONUMENT BOX IN C/L ISLAND ROAD & S.LINE O.L. 34

NO. 22637

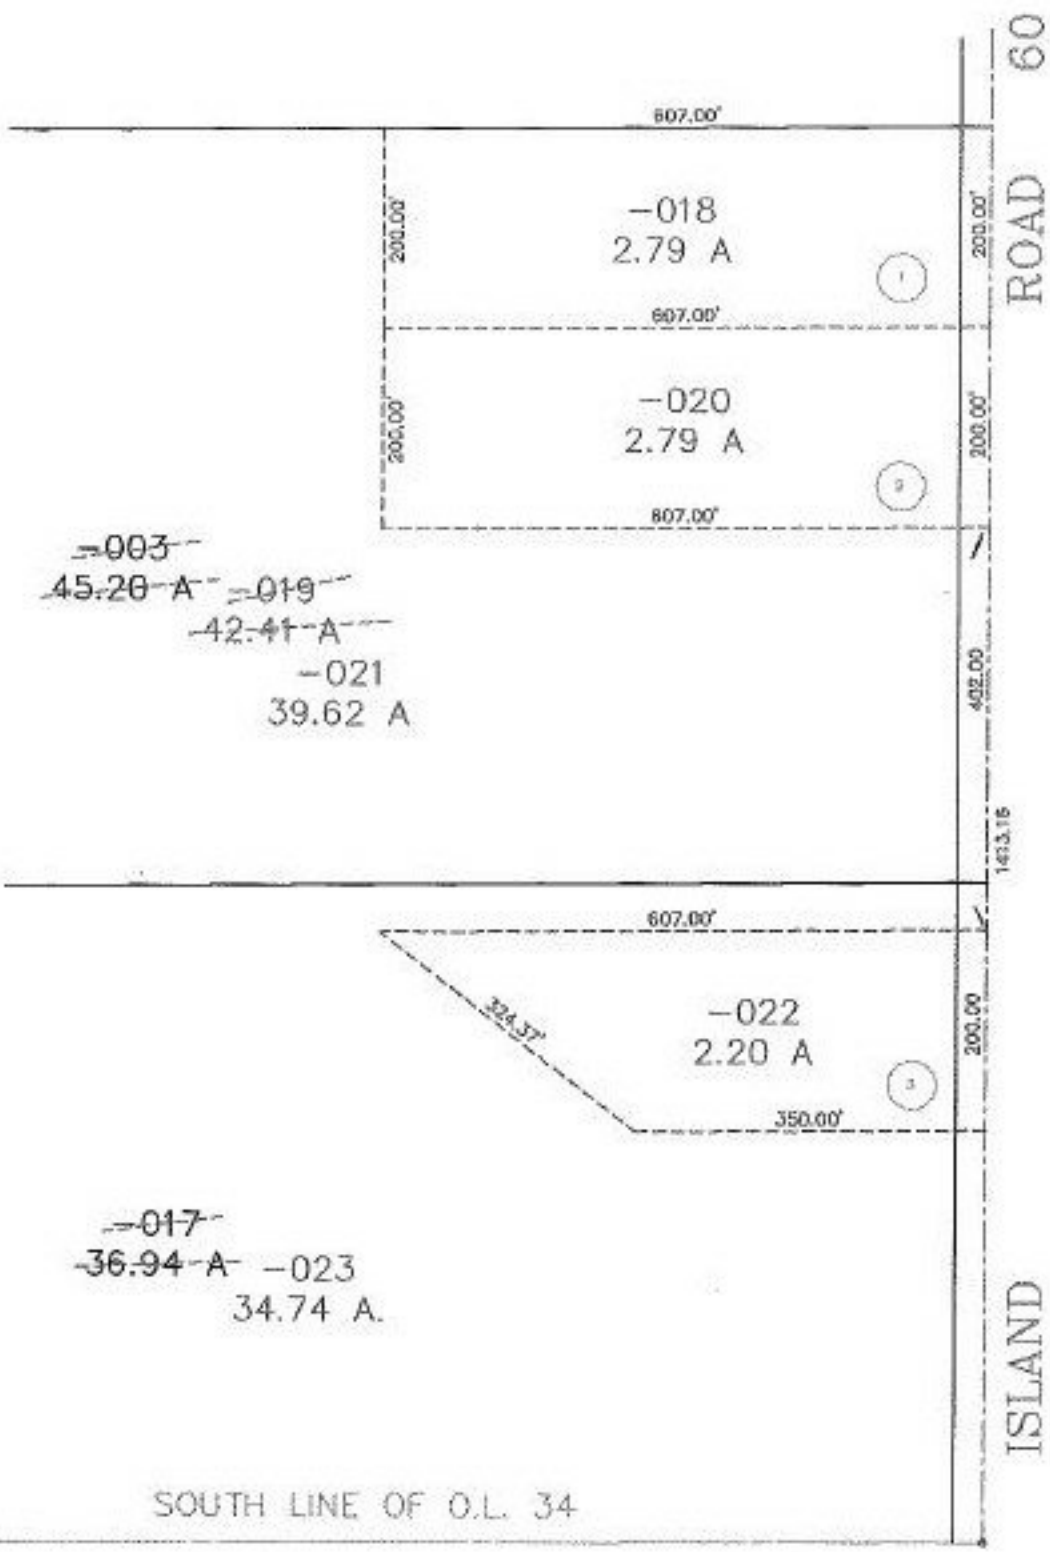

40 N / 215 / 187

4-21-99
M.B.



SPLITS/DEEDS PROCESSED
LORAIN COUNTY TAX MAP DEPARTMENT
 226 MIDDLE AVE. ELYRIA, OHIO

SURVEYED BY: KEN A McCARTNEY
 CLOSURE: 0.02 / 10.000
 MAP PAGE(S): 16-C
 APPROVED BY: F. COLBERT DATE: 9/9/98
 SCALE: 1" = 200' PRIOR INSTRUMENT: OR1267/209