


2264

APPROVED
 LORAIN CO.
 MAP DEPT.
 DATE 11/18/89
 BY R. J. Bell

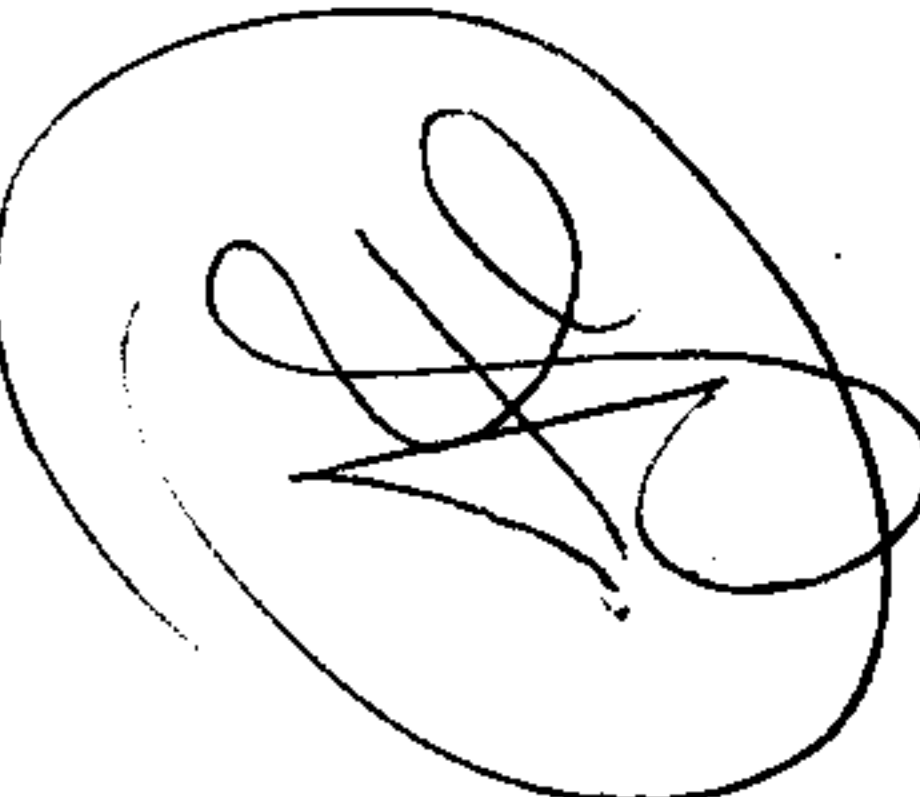

SEE 5-00-087
 WEST RIDGE 539.8

-001
 2.00 A.
 564.4
 -002
 2.00 A.

~~049~~
~~000~~
~~0.50 A.~~
~~38 A.~~
~~240~~

362.90
 -007
 0.48 A.

348.30
 -006
 0.60 A.

349.40
 -005
 0.64 A.

352.70
 -004
 0.49 A.

358.30

-019
 2.28 A.

-011
 0.60 A.

275.9

-012
 0.66 A.

301.25

MILAN - ELYRIA

2264