


VACATION AND APPORTIONMENT PLAT FOR

HIGHLAND AVENUE

VOL. 46

PG. 56

MAP  REGISTER   
\* DUPLICATE NEEDS  
PARCEL SIZE CORRECTION

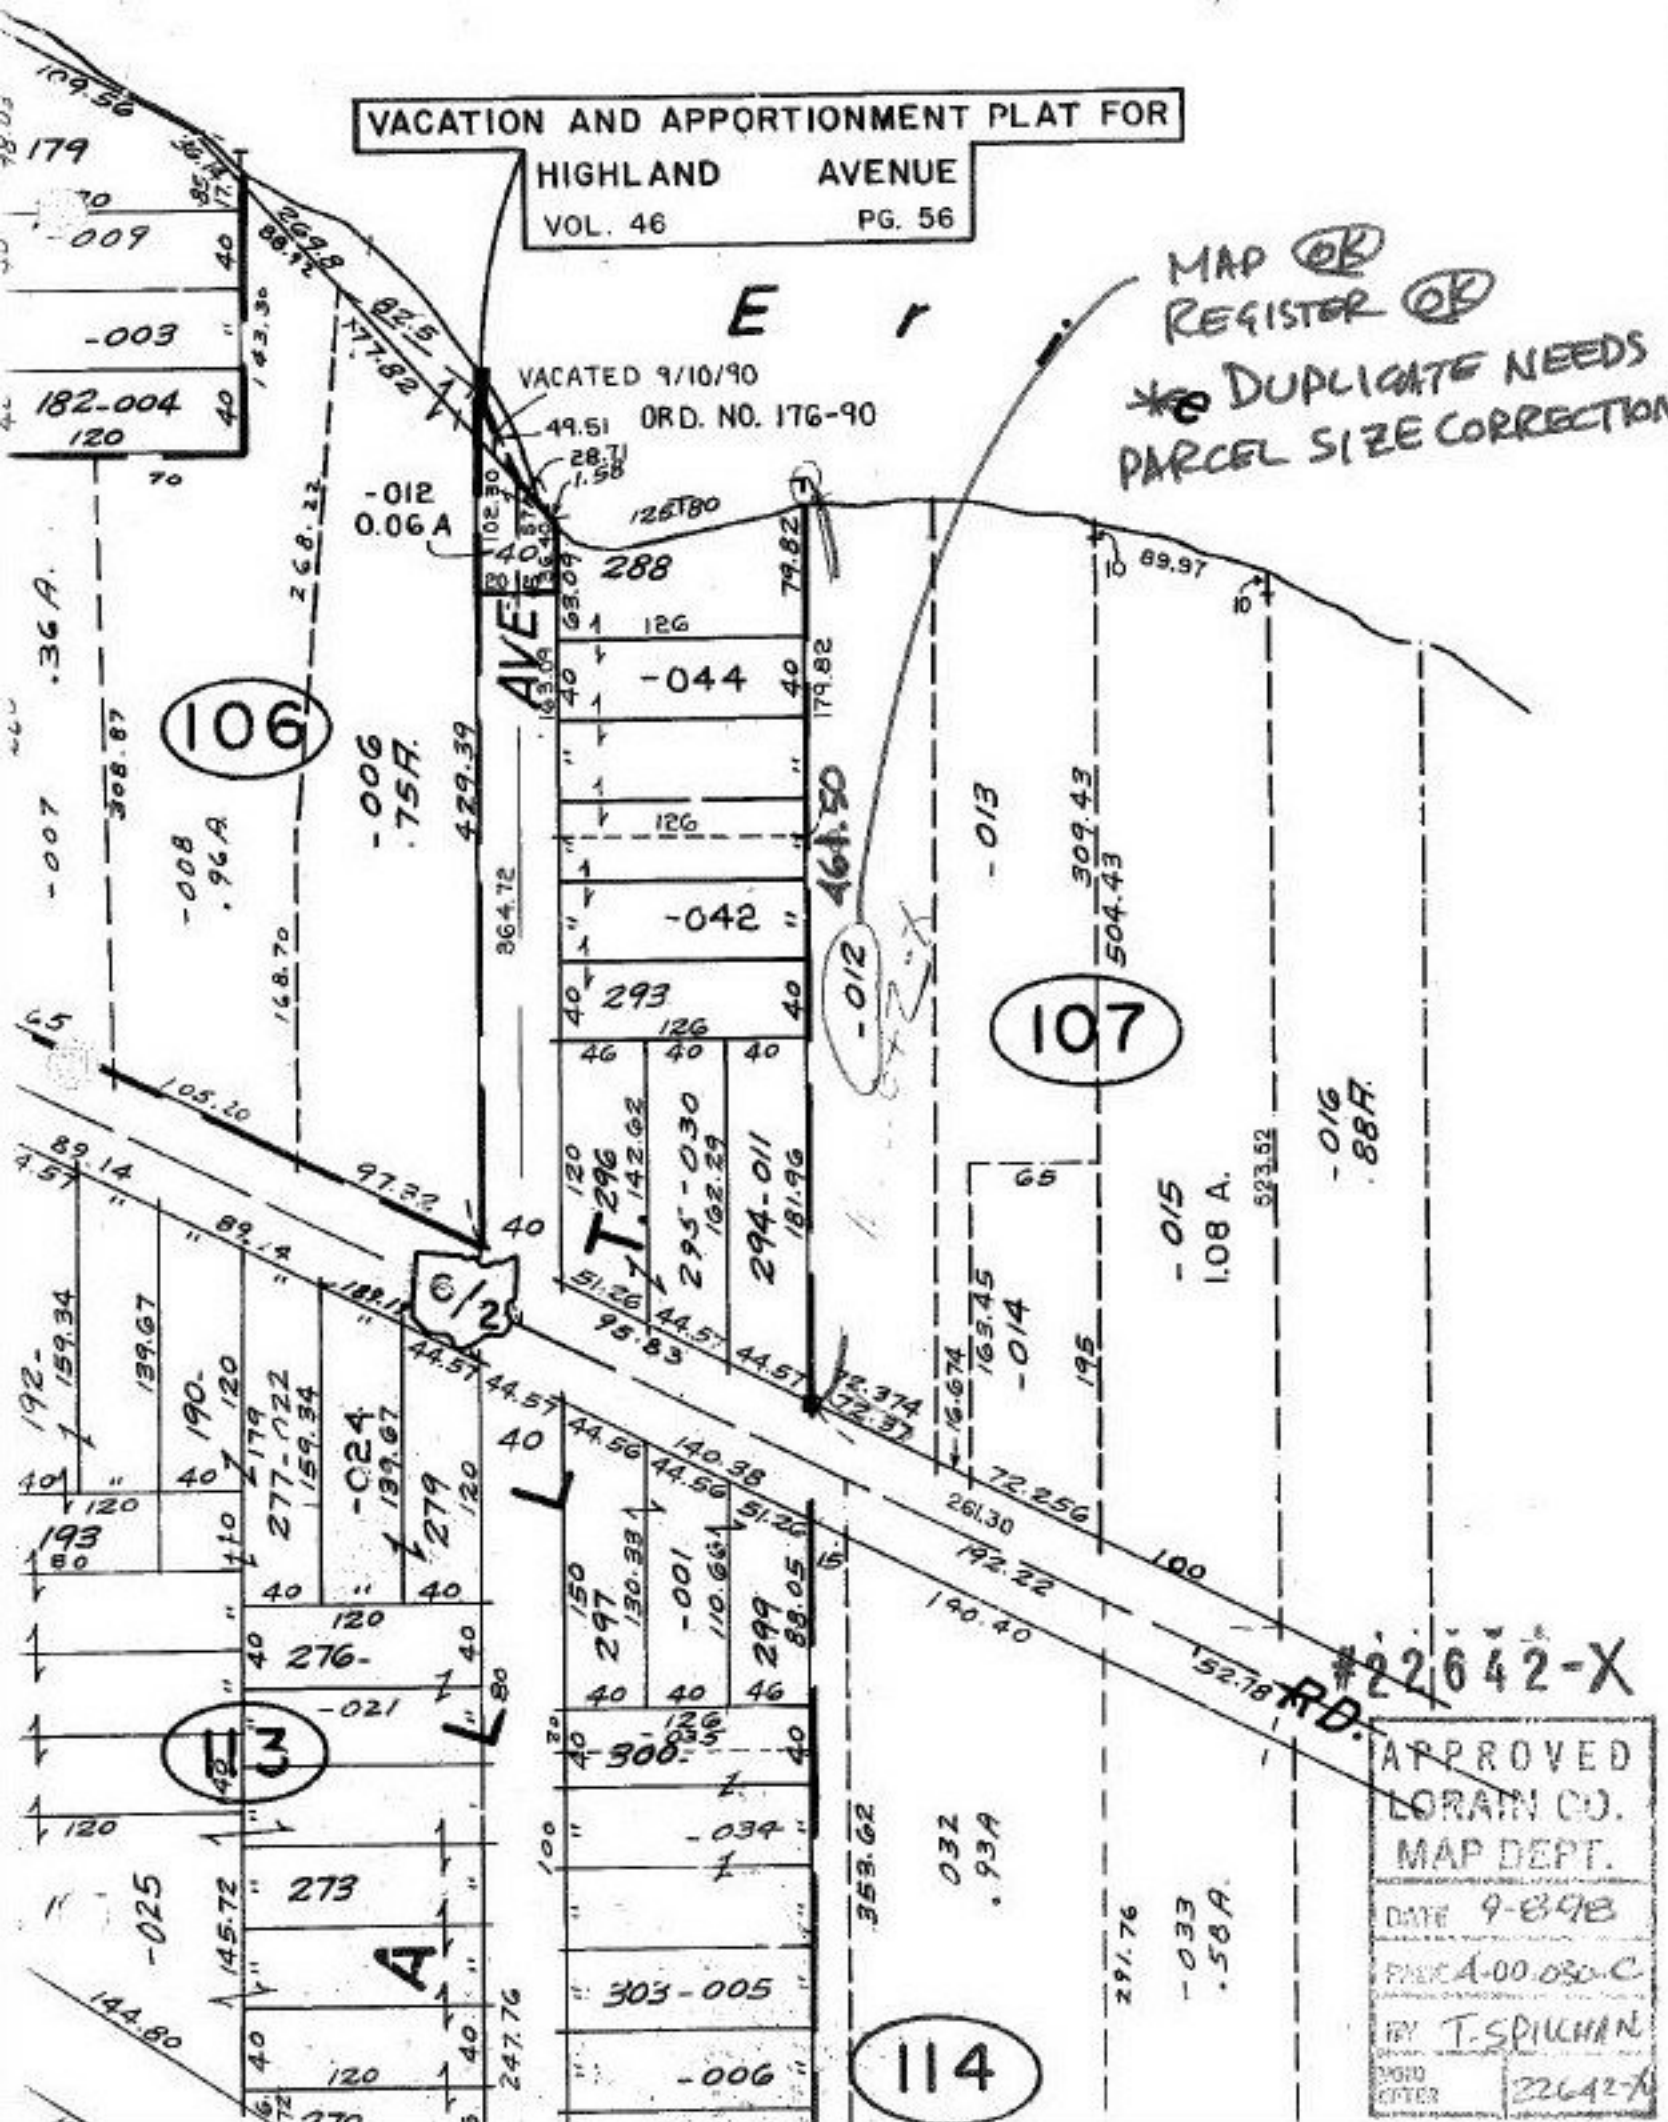

VACATED 9/10/90  
49.51 ORD. NO. 176-90

106

107

103

114

#22642-X  
RD.

APPROVED  
LORAIN CO.  
MAP DEPT.  
DATE 9-8-98  
PARCEL A-00-030-C  
BY T. SPILMAN  
DRAWN BY 22642-A