


PARENT PARCEL: 07-00-008-115-061

CHILD PARCEL: 07-00-008-074, 075

STARTING POINT: C/Ls CENTER RIDGE ROAD & BROAD BLVD.

NO. 22642

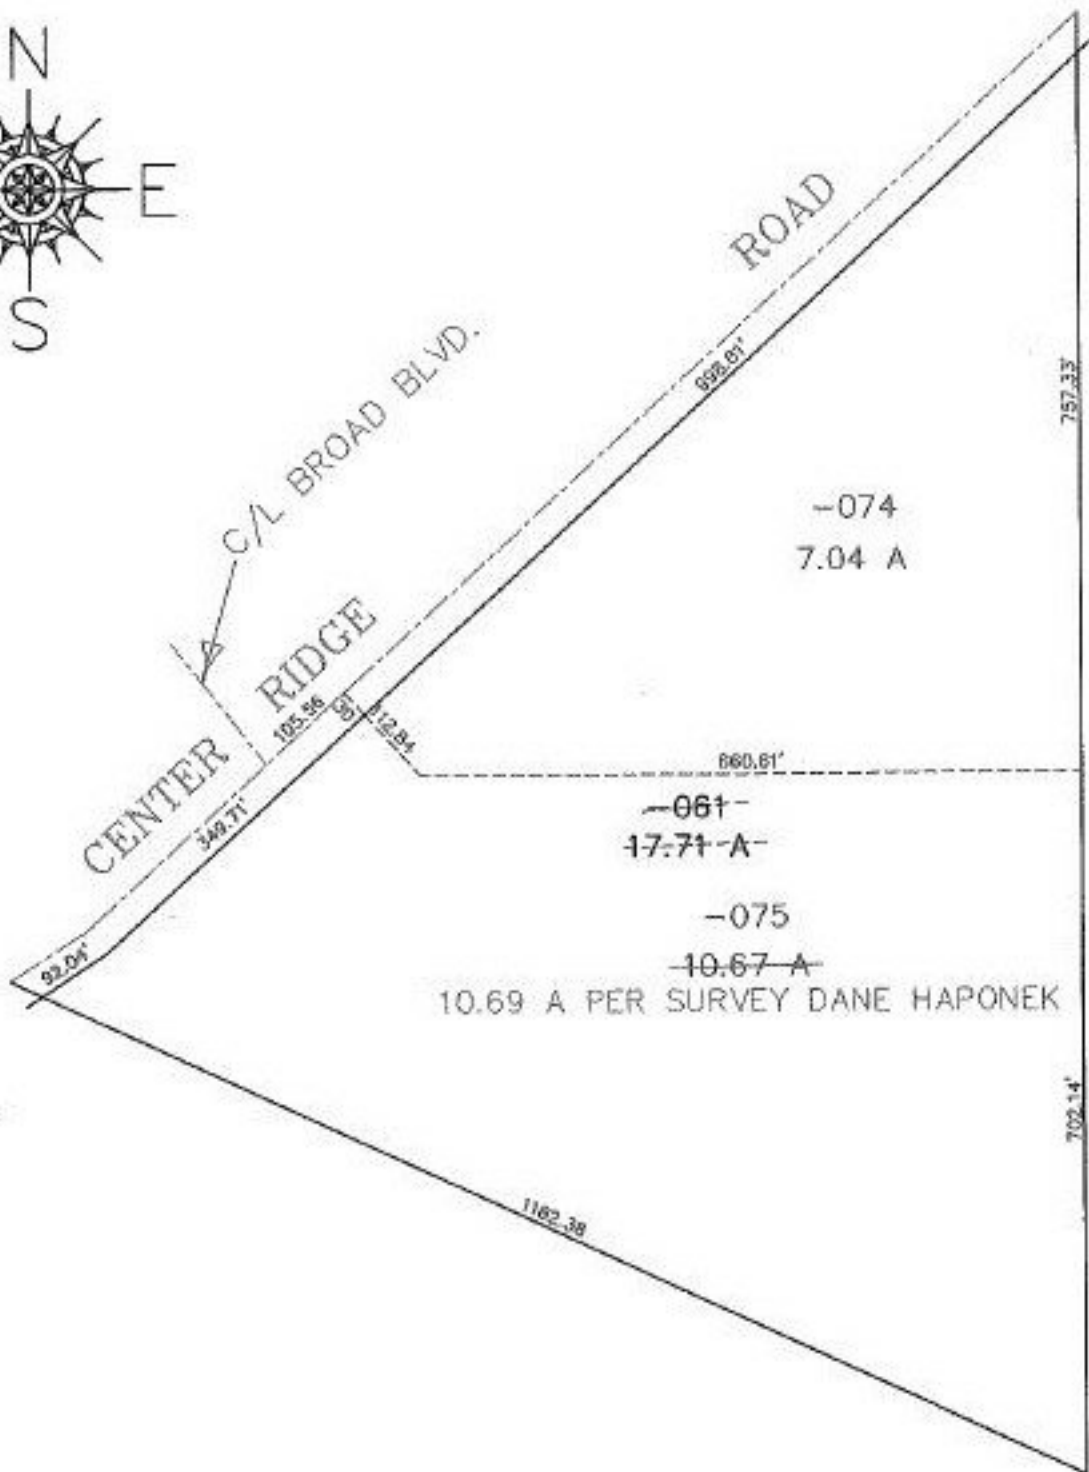

SPLITS/DEEDS PROCESSED
LORAIN COUNTY TAX MAP DEPARTMENT
 226 MIDDLE AVE. ELYRIA, OHIO

SURVEYED BY: DANE A. HAPONEK
 CLOSURE: 0.02 / 10.000
 MAP PAGE(S): 07-00-008-0 + 15
 APPROVED BY: D. POE DATE: 09/17/98
 SCALE: 1" = 200' PRIOR INSTRUMENT: DV1182/245