

PARENT PARCEL: 04-00-013-000-050, & 04-00-013-000-213

CHILD PARCEL: 04-00-013-000-215 THRU 217

STARTING POINT: CL OF AVON - BELDON RD. & CL OF RIEGELSBERGER RD.

NO. 22643



IRON PIPE


RIEGELSBERGER RD. 60'

60'

488.60'

RD.

AVON - BELDON RD.

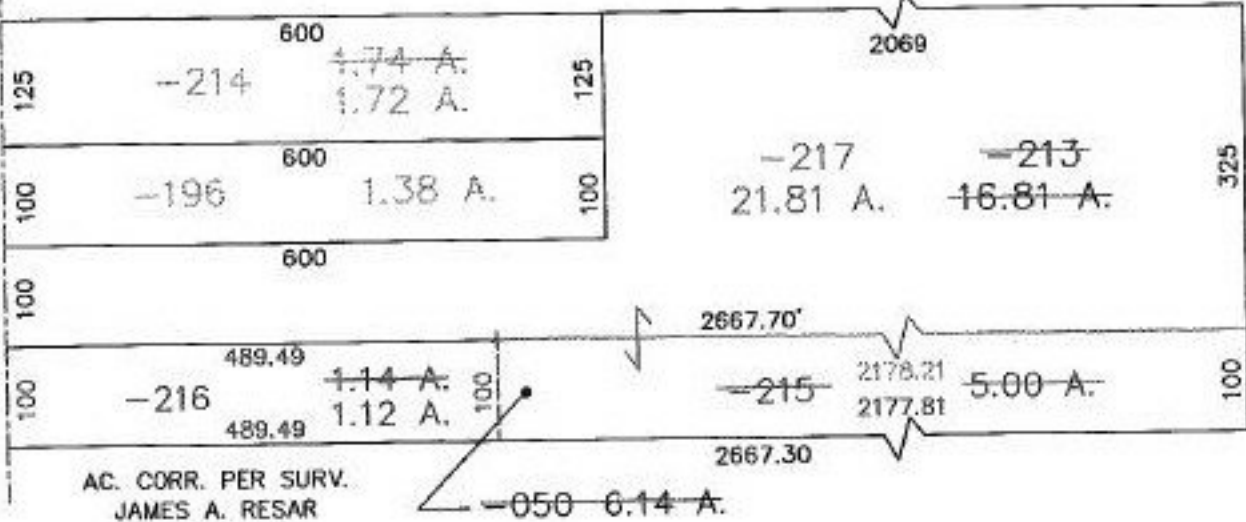

SPLITS/DEEDS PROCESSED
LORAIN COUNTY TAX MAP DEPARTMENT
226 MIDDLE AVE. ELYRIA, OHIO

SURVEYED BY: JAMES A. RESAR
CLOSURE: 0.00 : 10.000
MAP PAGE(S): 04-00-013-C & D
APPROVED BY: TJS DATE: 09/14/98
SCALE: 1" = 200' PRIOR INSTRUMENT: OR 615/447