


PARENT PARCEL: 12-00-023-000-024

CHILD PARCEL: 12-00-023-000-064 & -065

STARTING POINT: CL OF BOONE RD. & CL OF SNELL RD.

NO. 22648

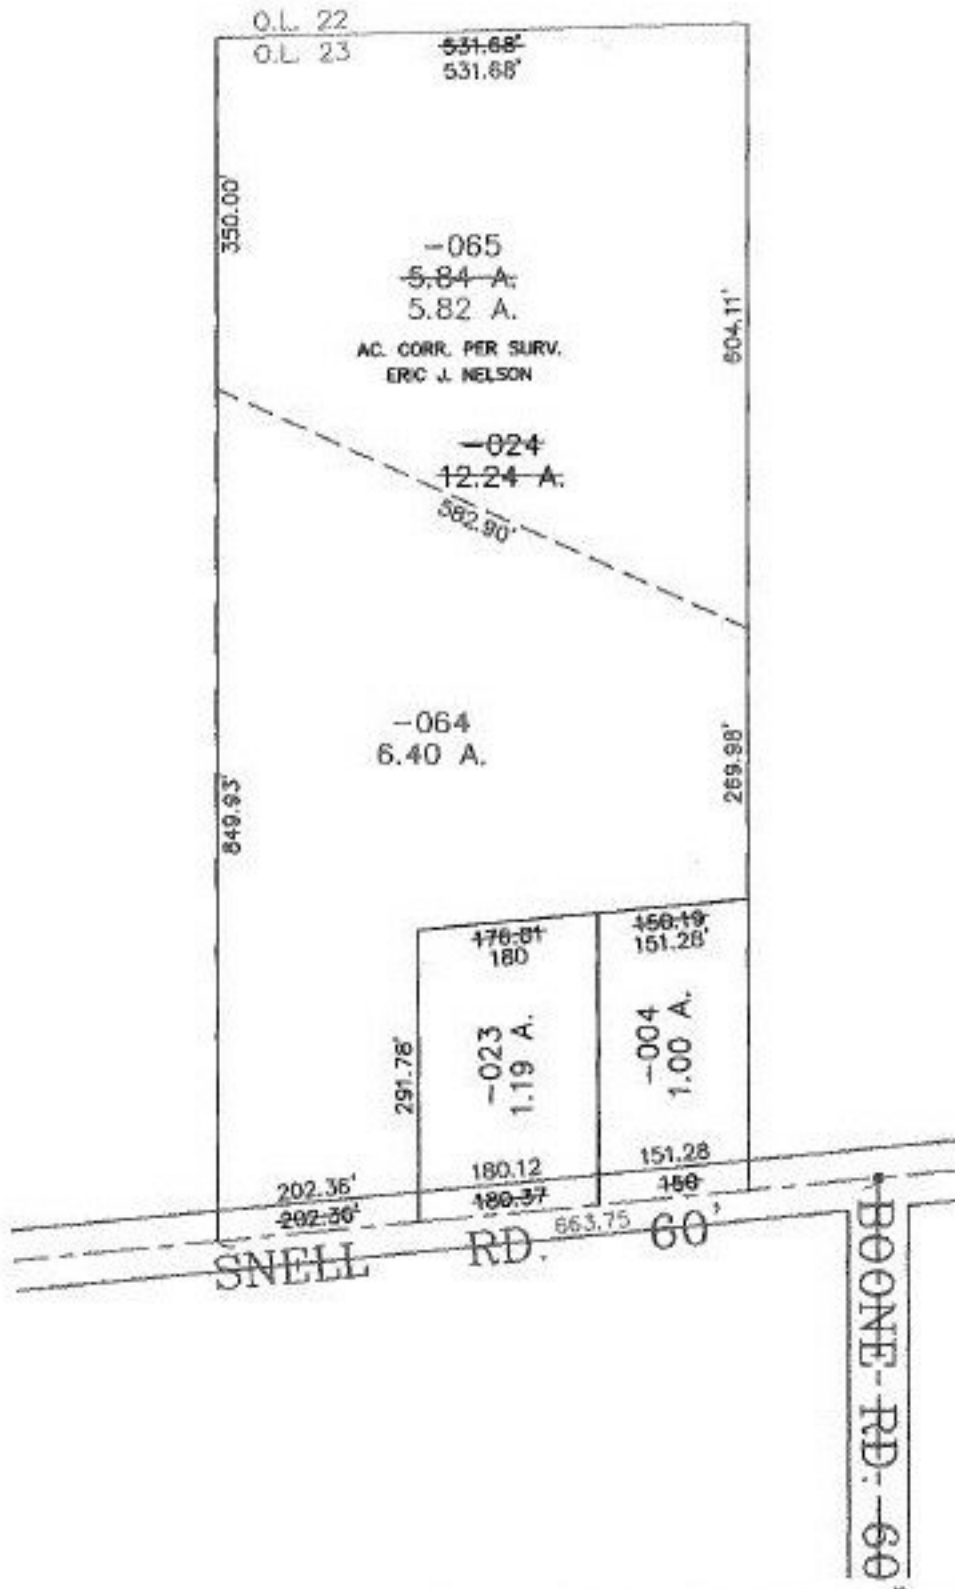

4-21-98
m.B.



SPLITS/DEEDS PROCESSED
 LORAIN COUNTY TAX MAP DEPARTMENT
 226 MIDDLE AVE. ELYRIA, OHIO

SURVEYED BY: ERIC J. NELSON
 CLOSURE: 0.05 : 10.000
 MAP PAGE(S): 12-00-023-B
 APPROVED BY: TJS DATE: 09/17/98
 SCALE: 1" = 200' PRIOR INSTRUMENT: OR 717/825