


PARENT PARCEL: 01-00-075-000-034 & 01-00-076-000-010

CHILD PARCEL: 01-00-075-000-037, 038, 039, 040

STARTING POINT: NW CORNER OF O.L. 75

NO. 22656

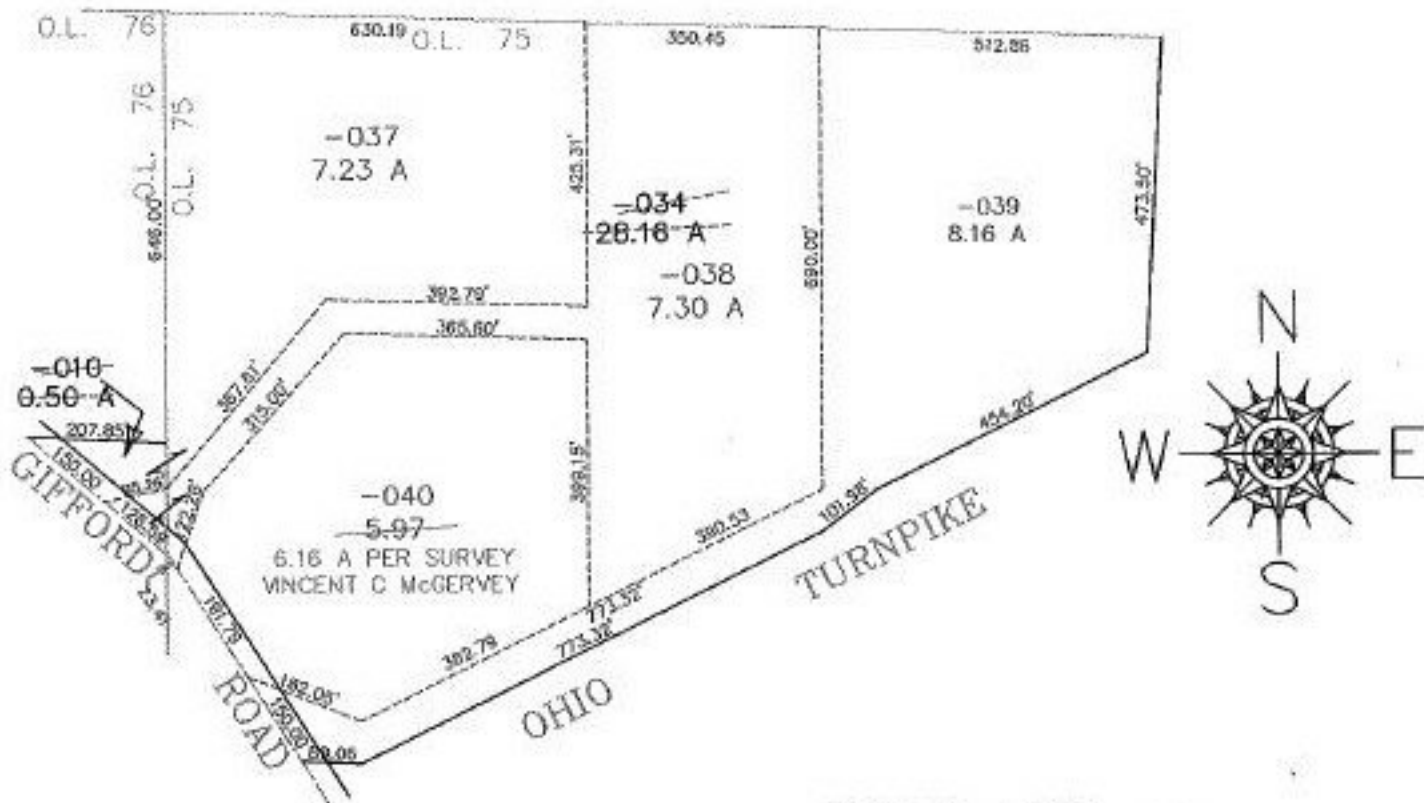

SCALE 1" = 400'

Sitow Hook



SPLITS/DEEDS PROCESSED
 LORAIN COUNTY TAX MAP DEPARTMENT
 226 MIDDLE AVE. ELYRIA, OHIO

SURVEYED BY: VINCENT C McGERVEY
 CLOSURE: 0.30 / 10,000
 MAP PAGE(S): 1-K
 APPROVED BY: F. COLBERT DATE: 9/24/98
 SCALE: 1" = 300' PRIOR INSTRUMENT: OR362/772