


PARENT PARCEL: 10-00-001-101-028

CHILD PARCEL: 10-00-001-101-074 & -075

STARTING POINT: CL OF RUSSIA RD. & S.W. CORNER OF CARLISLE TWP. O.L. 1

NO. 22657

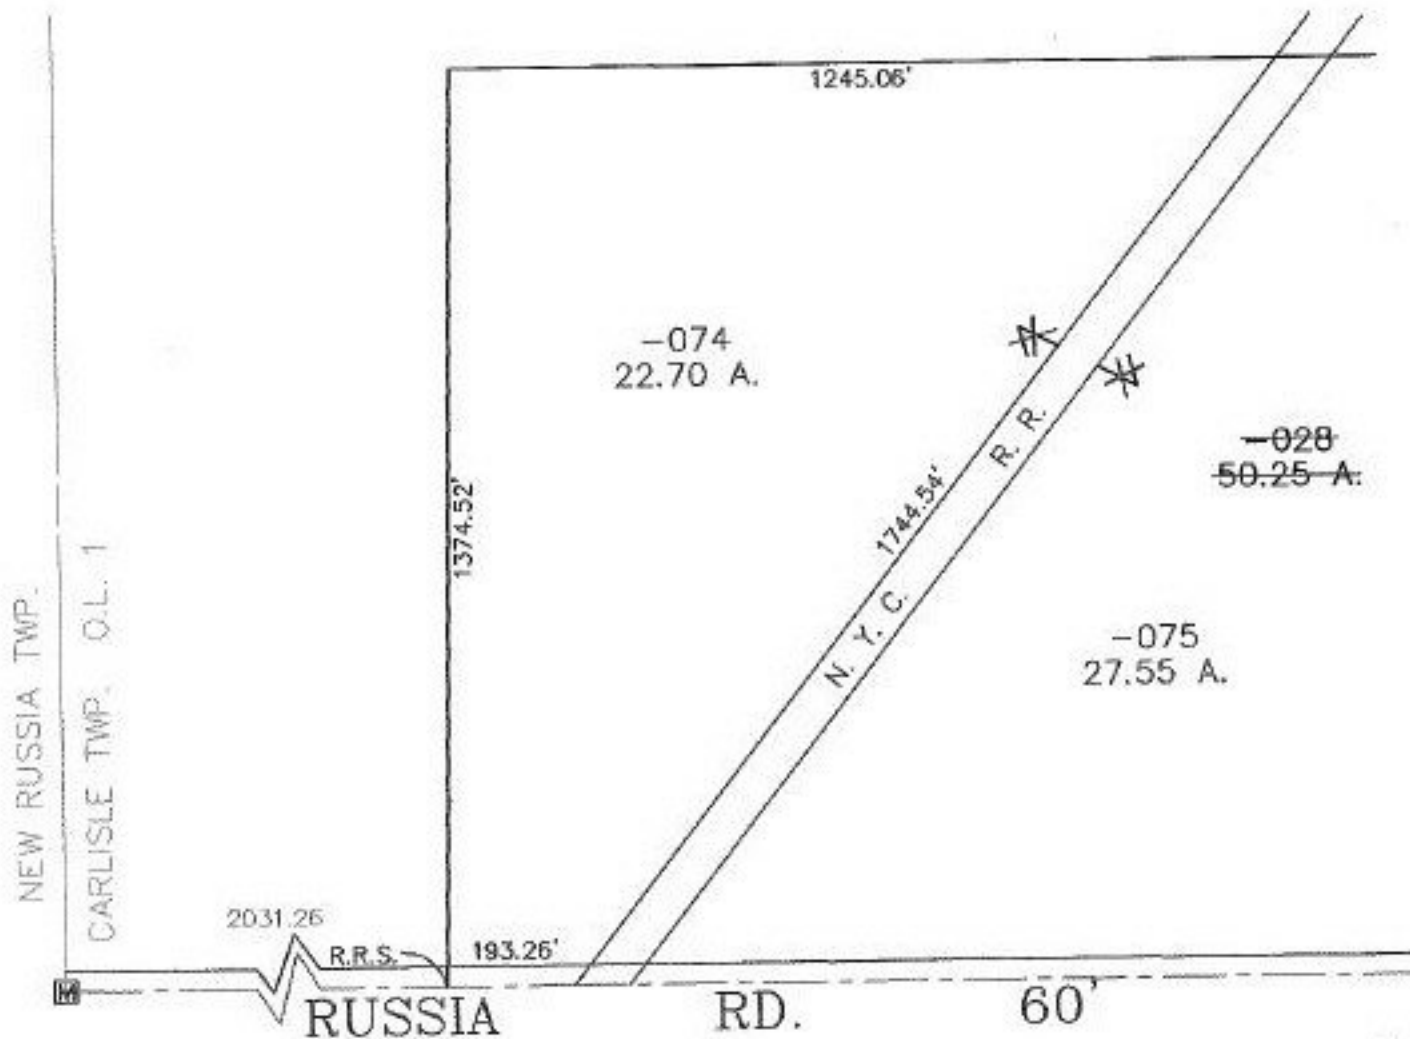

6/21/99

SURVEYED BY: LOWELL E. BENDER
 CLOSURE: 0.01 : 10.000
 MAP PAGE(S): 10-00-001-F & G
 APPROVED BY: TJS DATE: 09/24/98
 SCALE: 1" = 300' PRIOR INSTRUMENT: OR 1314/475

SPLITS/DEEDS PROCESSED

LORAIN COUNTY TAX MAP DEPARTMENT
226 MIDDLE AVE. ELYRIA, OHIO

