


#22659

O.L. 14

AC. CORR. PER SURV.
PATRICK A. MCGANNON

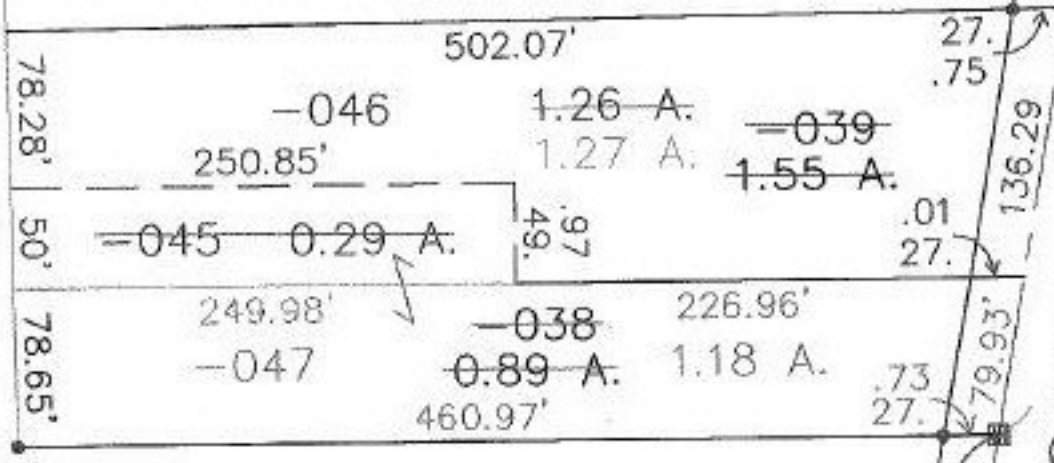

AMHERST RD. 60

PYLE SOUTH