


PARENT PARCEL: 01-00-034-000-003


CHILD PARCEL: 01-00-034-000-050 & -051

STARTING POINT: I.P., IN THE S.W. CORNER OF O.L. 34

NO. 22661

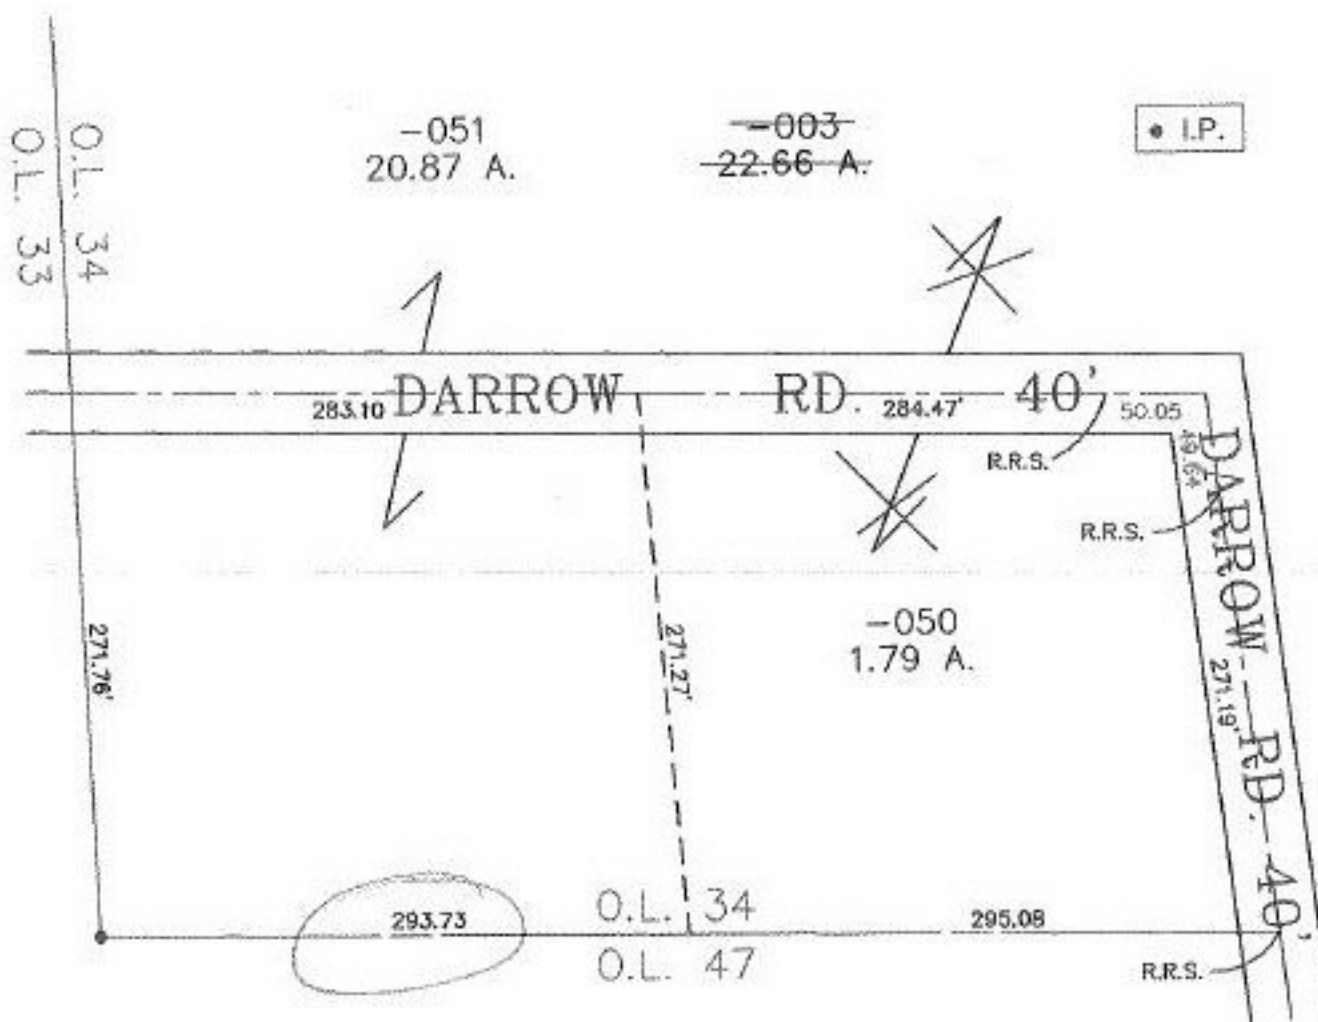

TS
2-19-99

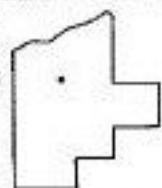

SPLITS/DEEDS PROCESSED
LORAIN COUNTY TAX MAP DEPARTMENT
226 MIDDLE AVE. ELYRIA, OHIO

SURVEYED BY: NEIL M. JUNKE
 CLOSURE: 0.04 : 10,000
 MAP PAGE(S): 1-E
 APPROVED BY: TJS DATE: 10/02/98
 SCALE: 1" = 100' PRIOR INSTRUMENT: DV 1199/243