


PARENT PARCEL: 04-00-019-144-022

CHILD PARCEL: 04-00-019-144-349 & -350

STARTING POINT: P.K. SPIKE AT, CL. OF LEAR NAGLE RD. & CL. OF DIVISION RD.

NO. 22664

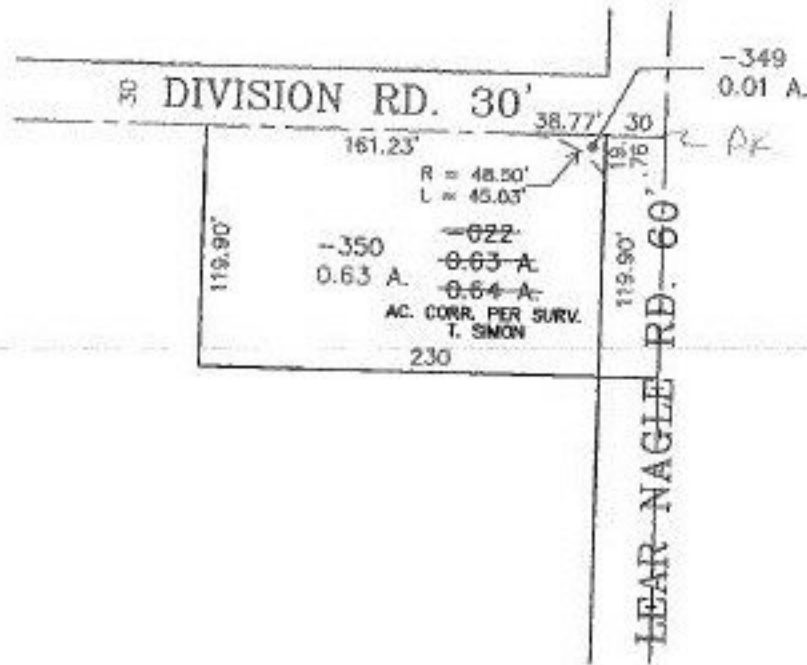

TS
2-18-99

SPLITS/DEEDS PROCESSED

LORAIN COUNTY TAX MAP DEPARTMENT
226 MIDDLE AVE. ELYRIA, OHIO

SURVEYED BY: THOMAS A. SIMON

CLOSURE: 0.15 : 10.000

MAP PAGE(S): 04-00-019-H

APPROVED BY: TJS DATE: 10/20/98

SCALE: 1" = 100' PRIOR INSTRUMENT: OR 269/336