



PARENT PARCEL: XX-XX-XXX-XXX-XXX 04-00-614-
 CHILD PARCEL: XX-XX-XXX-XXX-XXX
 STARTING POINT: XXXXXX

NO. 22668

ST. 50 60
 11-026
 104
 50
 AVE.

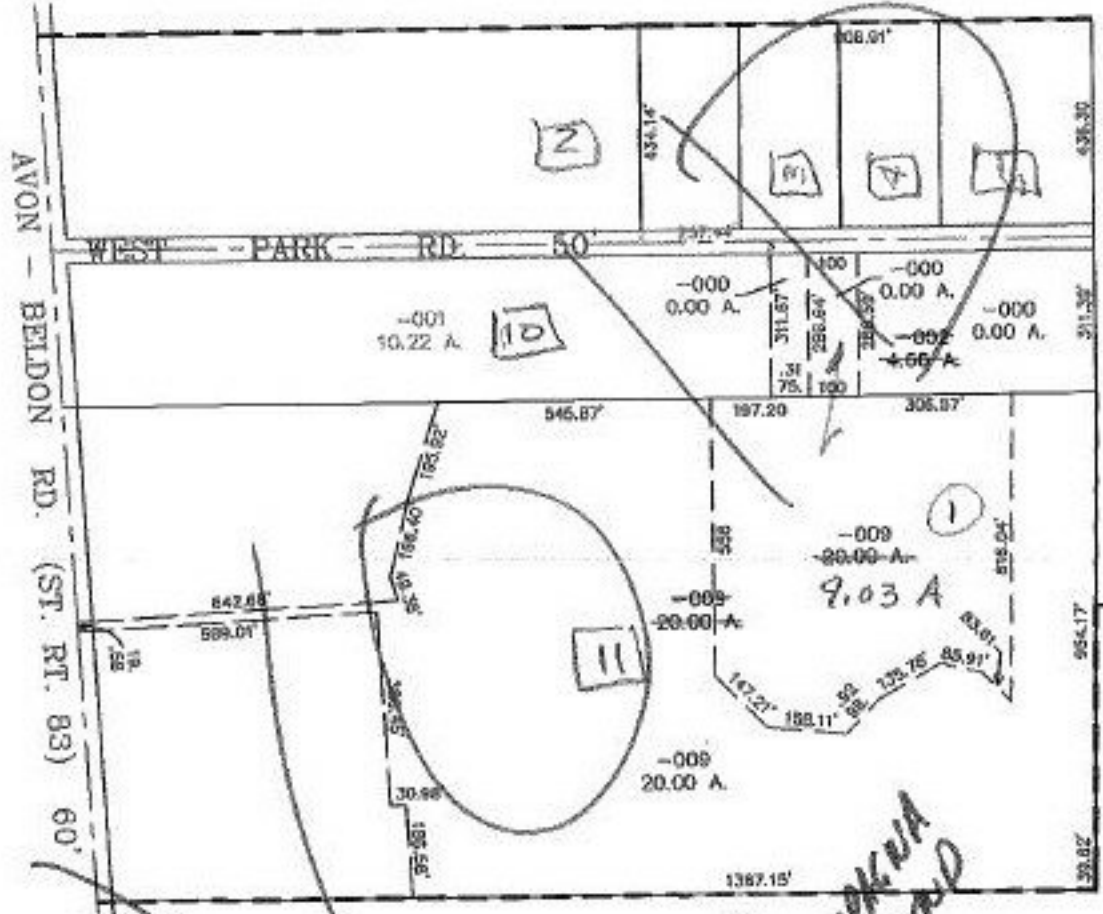

*1/20/99 PER
 DEE CAMPANA
 MIDLAND
 NEW DESC.*

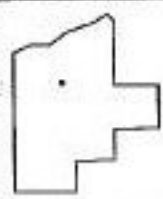

SPLITS/DEEDS PROCESSED
 LORAIN COUNTY TAX MAP DEPARTMENT
 226 MIDDLE AVE. ELYRIA, OHIO

SURVEYED BY: XXXXXXXXXXXX
 CLOSURE: XXXXXX
 MAP PAGE(S): XX-XX-XXX 4-00-014-C
 APPROVED BY: XXX DATE: XX/XX/XX
 SCALE: 1" = 400' PRIOR INSTRUMENT: DV XXXX/XXX