


PARENT PARCEL: 05-00-032-000-094

CHILD PARCEL: 05-00-032-000-105 & -106

STARTING POINT: MON. BOX, CL OF ELYRIA-MILAN RD. & NORTH LINE OF O.L. 32

NO. 22679

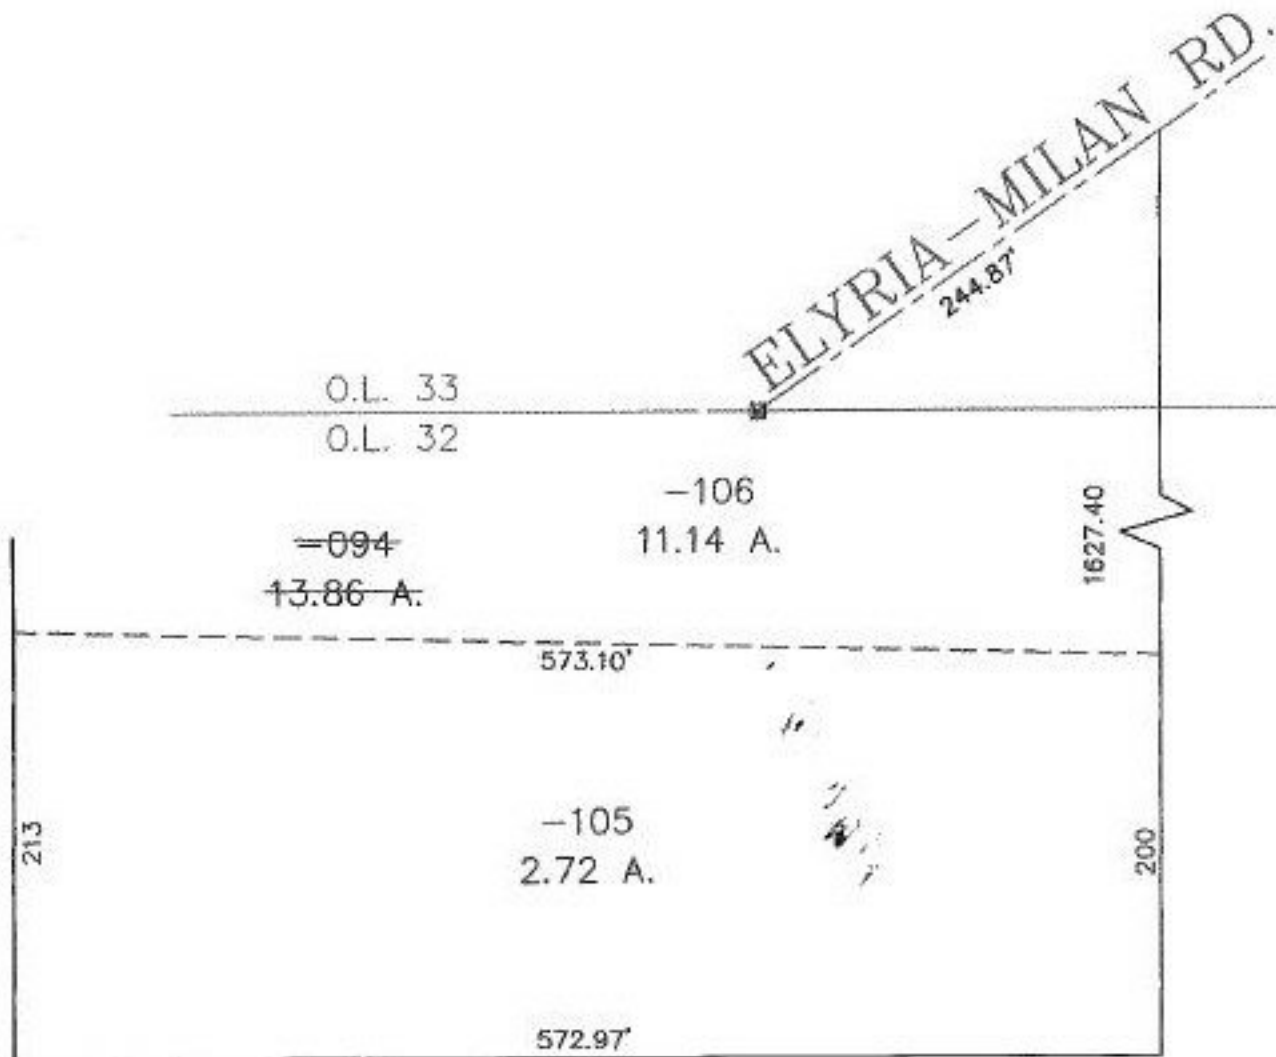

SPLITS/DEEDS PROCESSED

LORAIN COUNTY TAX MAP DEPARTMENT
226 MIDDLE AVE. ELYRIA, OHIO

SURVEYED BY: JOHN POZYWAK

CLOSURE: 0.06 : 10,000

MAP PAGE(S): 05-00-032-A

APPROVED BY: TJS DATE: 10/22/98

SCALE: 1" = 100' PRIOR INSTRUMENT: DV 1275/108