
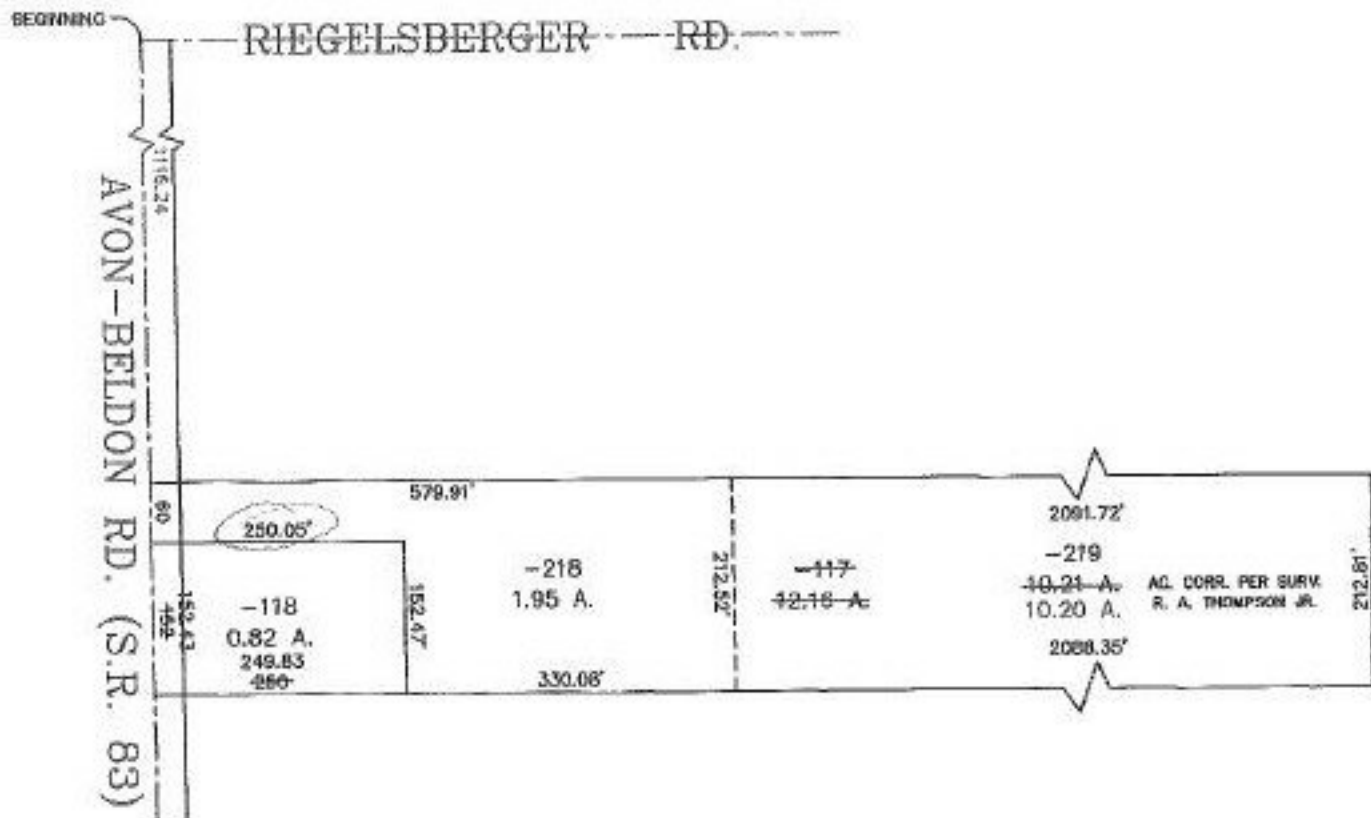


PARENT PARCEL: 04-00-013-000-117

CHILD PARCEL: 04-00-013-000-218 & -219

STARTING POINT: XXXXXX

NO. 22680

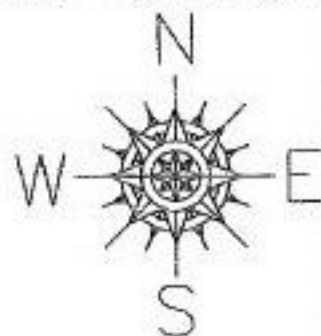

SPLITS/DEEDS PROCESSED

LORAIN COUNTY TAX MAP DEPARTMENT
226 MIDDLE AVE. ELYRIA, OHIO

SURVEYED BY: RICHARD A. THOMPSON JR.

CLOSURE: 0.04 : 10,000

MAP PAGE(S): 04-00-013-C & D

APPROVED BY: TJS DATE: 10/22/98

SCALE: 1" = 200' PRIOR INSTRUMENT: DV 1242/15