


SPLIT & COMB.  
DONE

MAP UPDATED  
ALL DOCUMENTS ARE  
FILED

# 22681

SEE # 22501-D.

# 21881-D.  
21287

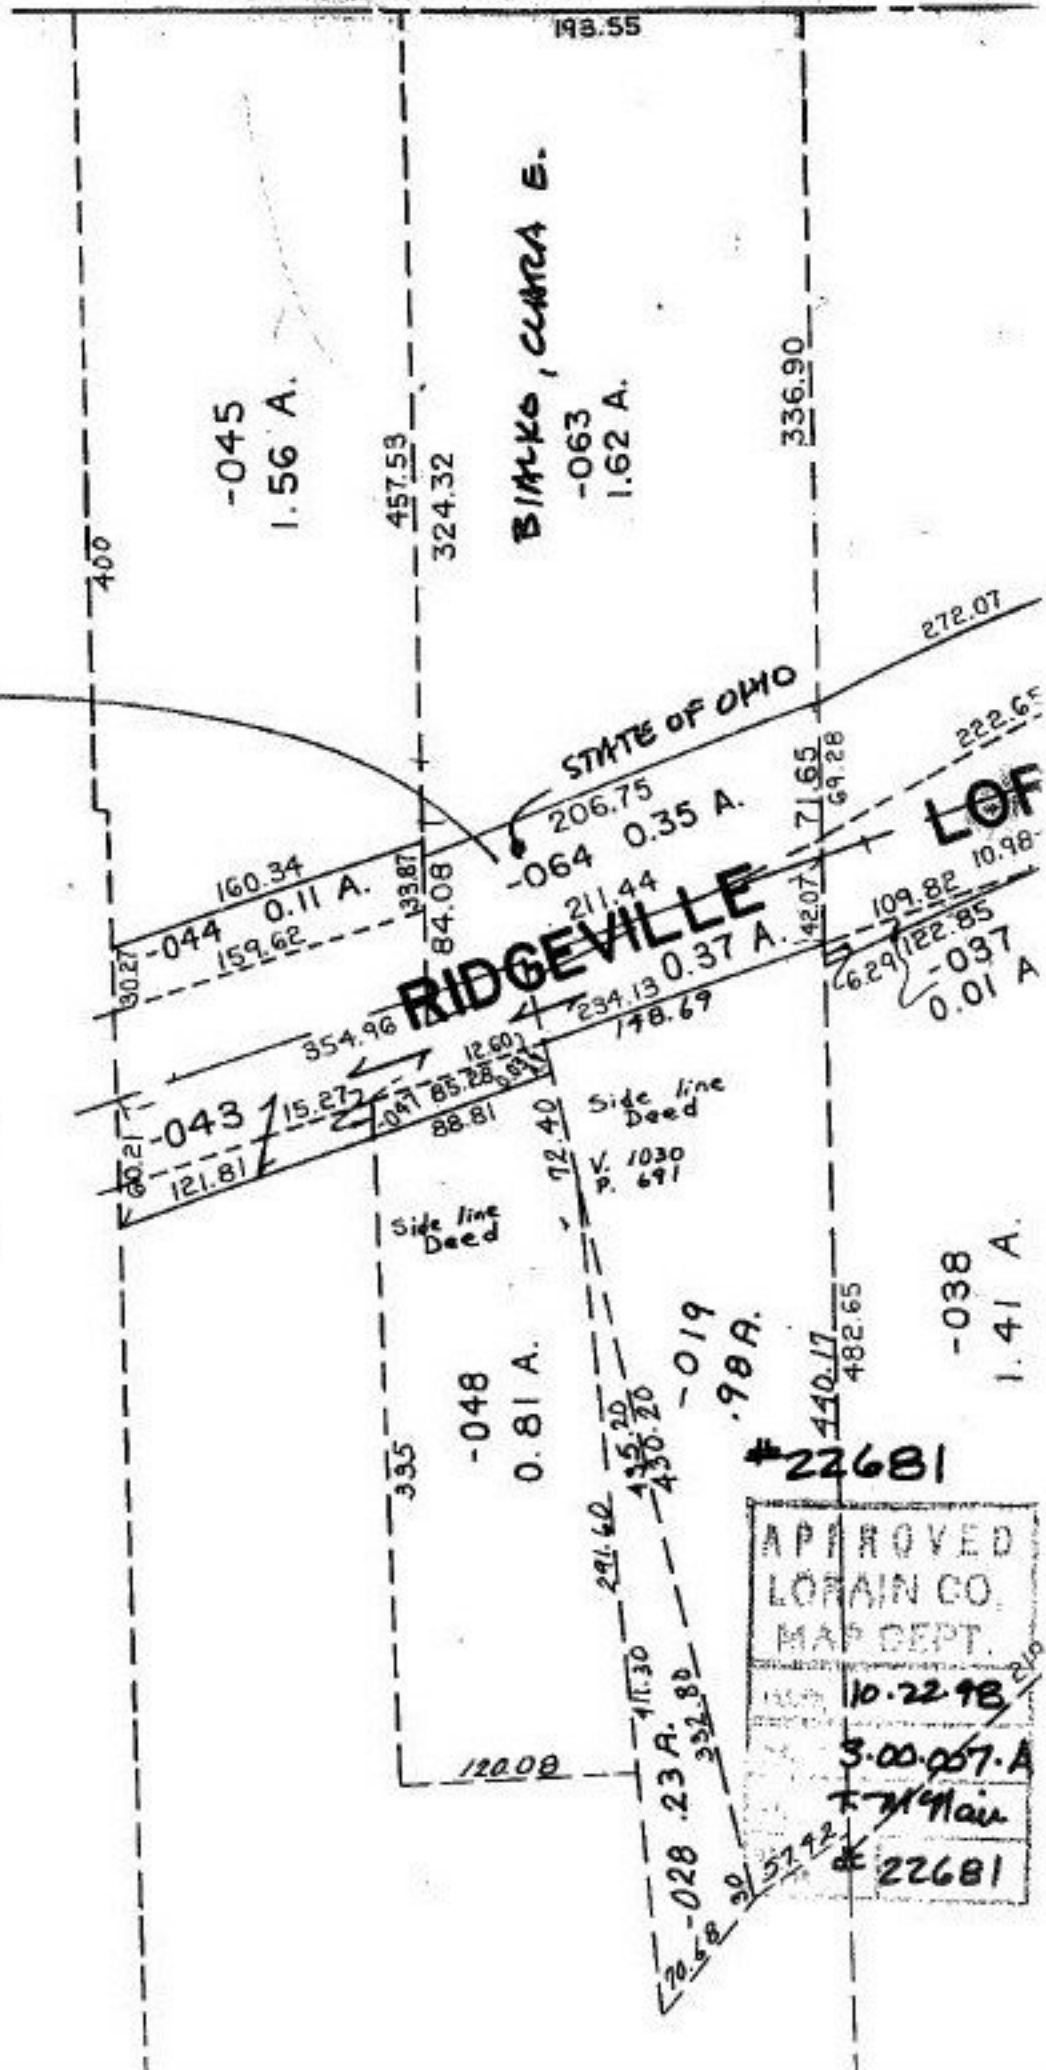

193.55

-045  
1.56 A.

BANKO, CURRA E.

-063  
1.62 A.

336.90

400

457.53  
324.32

STATE OF OHIO

160.34  
-044 0.11 A.  
159.62

-064 0.35 A.  
206.75  
211.44

272.07

222.65  
LOF

RIDGEVILLE

354.96  
-043 15.27  
121.81

234.13 0.37 A.  
178.69

109.82  
-037  
0.01 A.

Side line Deed  
V. 1030  
P. 691

Side line Deed

-048  
0.81 A.

-019  
.98 A.

-038  
1.41 A.

# 22681

APPROVED  
LORAIN CO.  
MAP DEPT.  
10.22.98  
3.00.057.A  
F.M. Main  
# 22681

120.00

291.60

111.30

23 A.

352.80

440.17  
482.65

57.92