


PARENT PARCEL: 03-00-007-101-046, & -047  
CHILD PARCEL: 03-00-007-101-062, -063, & -064  
STARTING POINT: N.E. CORNER OF O.L. 7

NO. 22681



457.53  
408.40

408.55

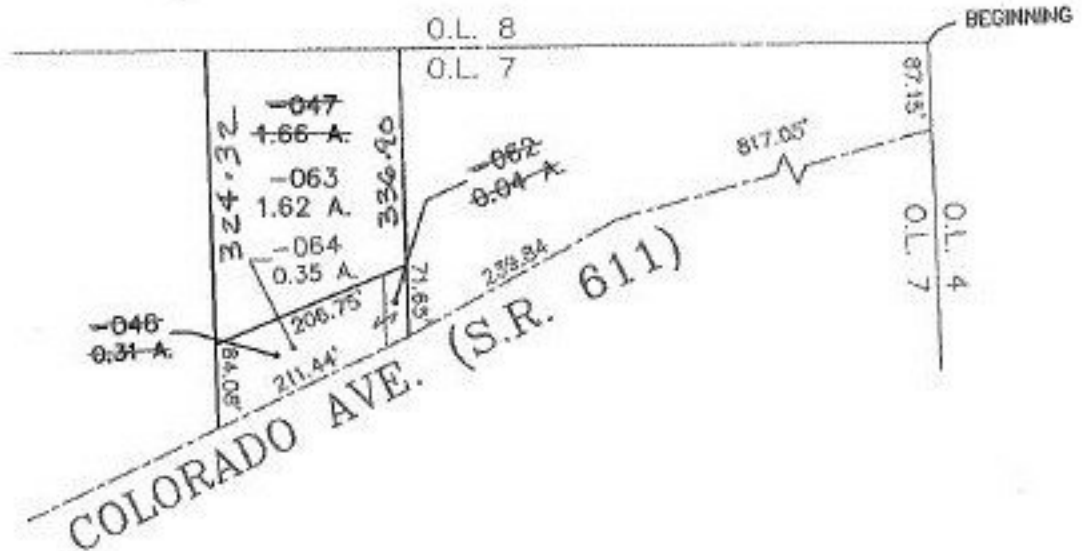

**SPLITS/DEEDS PROCESSED**  
LORAIN COUNTY TAX MAP DEPARTMENT  
228 MIDDLE AVE. ELYRIA, OHIO

SURVEYED BY: JAMES E. KENYON  
CLOSURE: 0.02 : 10,000  
MAP PAGE(S): 03-00-007-B  
APPROVED BY: TJS DATE: 10/22/98  
SCALE: 1" = 200' PRIOR INSTRUMENT: DV 1412/595