

PARENT PARCEL: 18-00-021-112-010

CHILD PARCEL: NONE

STARTING POINT: PT. OF S\L 36 & 37

NO. 22683-D



MAP & DUP. CORRECTION

DEPTH CORRECTION


18-00-021-112-010

~~69 X 101~~

69 X 181.50

AC. CORR. PER DEED

O.R. 832/881

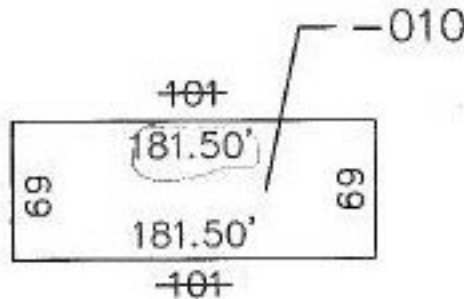

SPLITS/DEEDS PROCESSED

LORAIN COUNTY TAX MAP DEPARTMENT
226 MIDDLE AVE. ELYRIA, OHIO

SURVEYED BY: DEED

CLOSURE: CAN'T RUN

MAP PAGE(S): 18-00-021-C

APPROVED BY: IJS DATE: 10/26/98

SCALE: 1" = 100' PRIOR INSTRUMENT: OR 832/881