


PARENT PARCEL: 04-00-017-102-051, -052, -062, -081, & -082


CHILD PARCEL: NONE

STARTING POINT: XXXXXX

NO. 22687-D

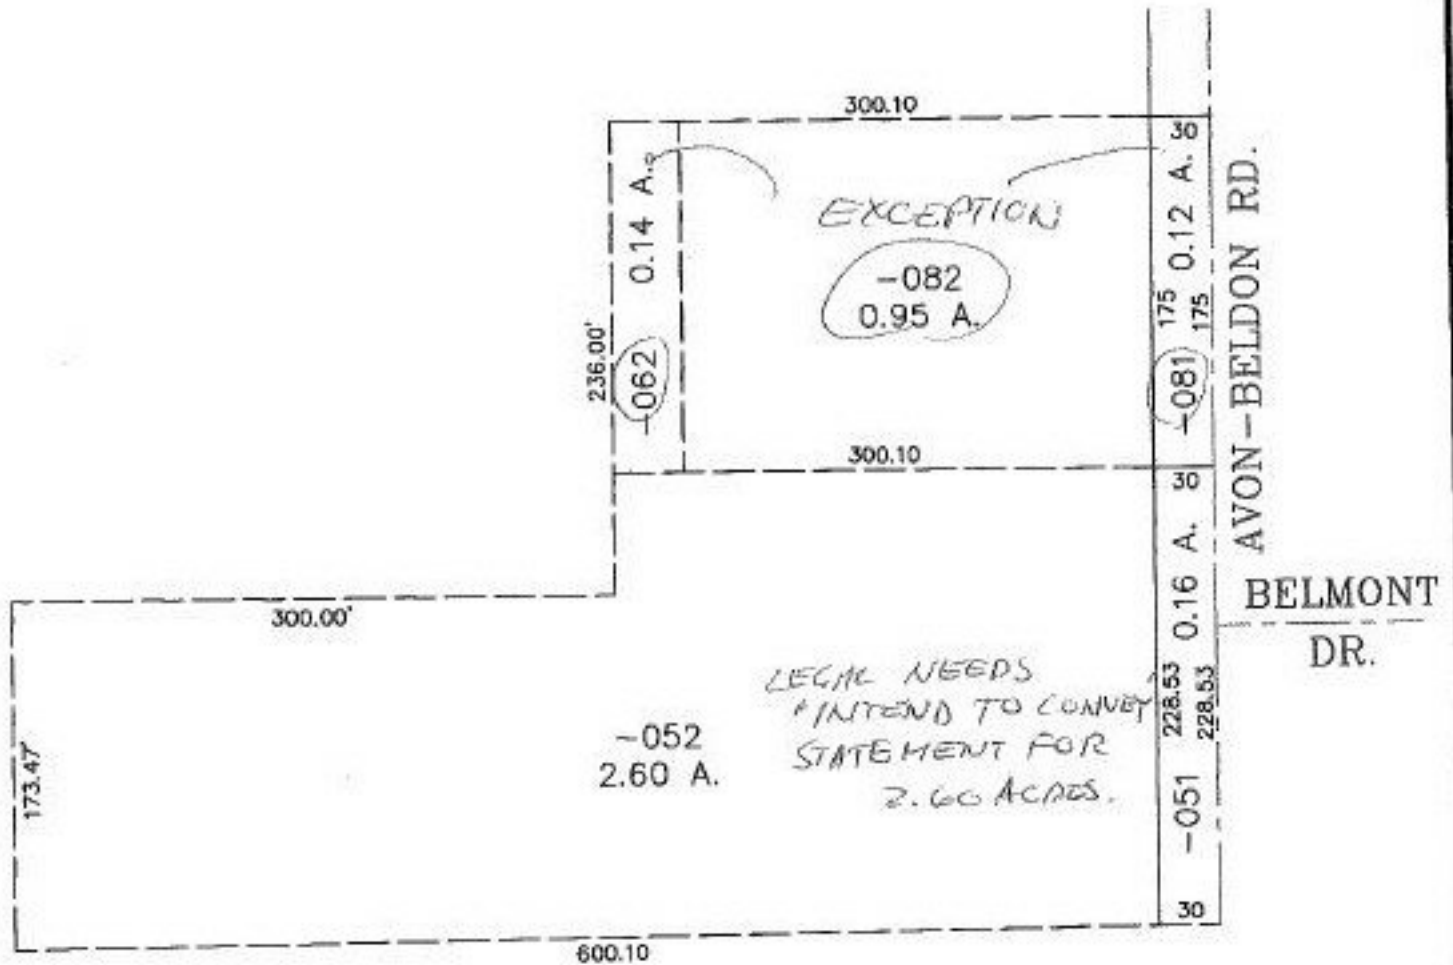

2 OF 2

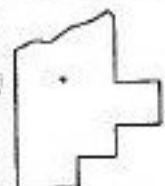

**SPLITS/DEEDS PROCESSED**

LORAIN COUNTY TAX MAP DEPARTMENT  
226 MIDDLE AVE. ELYRIA, OHIO

SURVEYED BY: RICHARD D. KELLER

CLOSURE: 0.15 : 10.000

MAP PAGE(S): 04-00-017-F

APPROVED BY: TJS DATE: 10/27/98

SCALE: 1" = 100' PRIOR INSTRUMENT: OR 1248/396