
PARENT PARCEL- 19-03-009-000-008

CHILD PARCEL: NONE

DP 1-6-99

STARTING POINT: S.E. CORNER OF LAND CONVEYED TO CHESTER EGLIN

NO. 22688-D

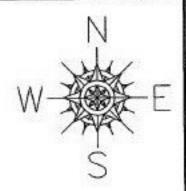

DEED CHECK


UPDATE LEGAL: 19-03-009-000-008

NO TRANSFER

DEED DOESN'T READ AROUND PARCEL
&

ACREAGE DOESN'T MATCH

4.77 A. MAP 3.70 A. DEED

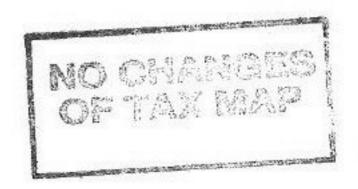

PETERENCE DV 939/693

SPLITS/DEEDS PROCESSED

LORAIN COUNTY TAX MAP DEPARTMENT 226 MIDDLE AVE. ELYRIA, OHIO

SURVEYED	BY-	NONE
SURVE IEU	D1:-	PACAGE

CLOSURE: CAN'T RUN

MAP PAGE(S): 19-E

APPROVED BY: TJS DATE: 11/02/98

SCALE: 1"= 100 PRIOR INSTRUMENT: DV 939/603