
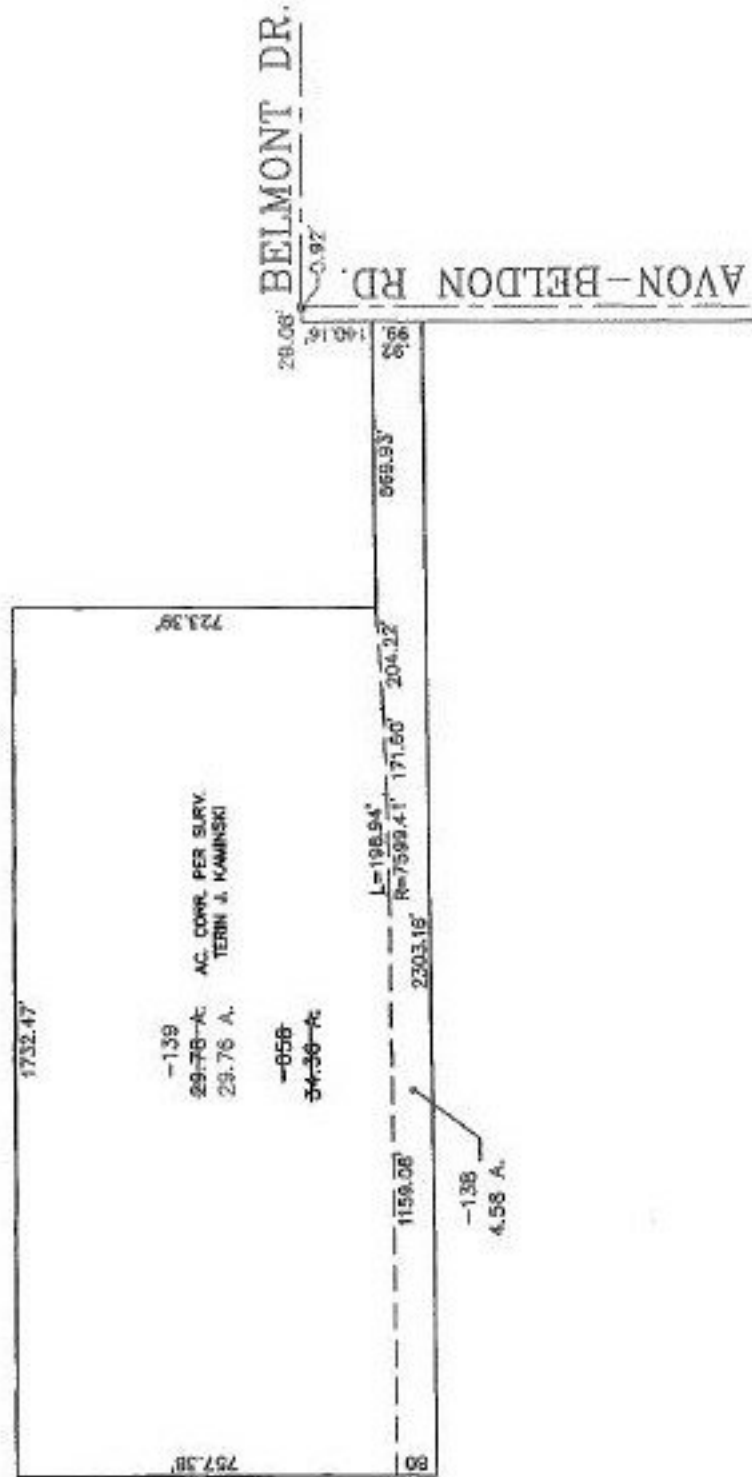


PARENT PARCEL: 04-00-017-102-058

CHILD PARCEL: 04-00-017-102-138, & -139

STARTING POINT: CL OF AVON BELDON RD. & CL OF BELMONT DR.

NO. 22694

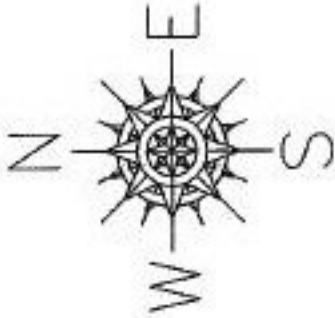

**SPLITS/DEEDS PROCESSED**  
**LORAIN COUNTY TAX MAP DEPARTMENT**  
 226 MIDDLE AVE. ELYRIA, OHIO

SURVEYED BY: TERIN J. KAMINSKI  
 CLOSURE: 0.03 : 10.000  
 MAP PAGE(S): 04-00-017-F & F  
 APPROVED BY: IJS DATE: 11/05/98  
 SCALE: 1" = 400 PRIOR INSTRUMENT: OR 98/679