

PARENT PARCEL: 04-00-008-104-085



CHILD PARCEL: 04-00-008-104-100 THRU -102

STARTING POINT: MON. BOX, CL OF PIN OAK PKWY. AT STA. 10+20.00

NO. 22695



☒	MON. BOX
△	R.R.S.
•	I.P.

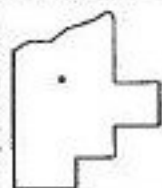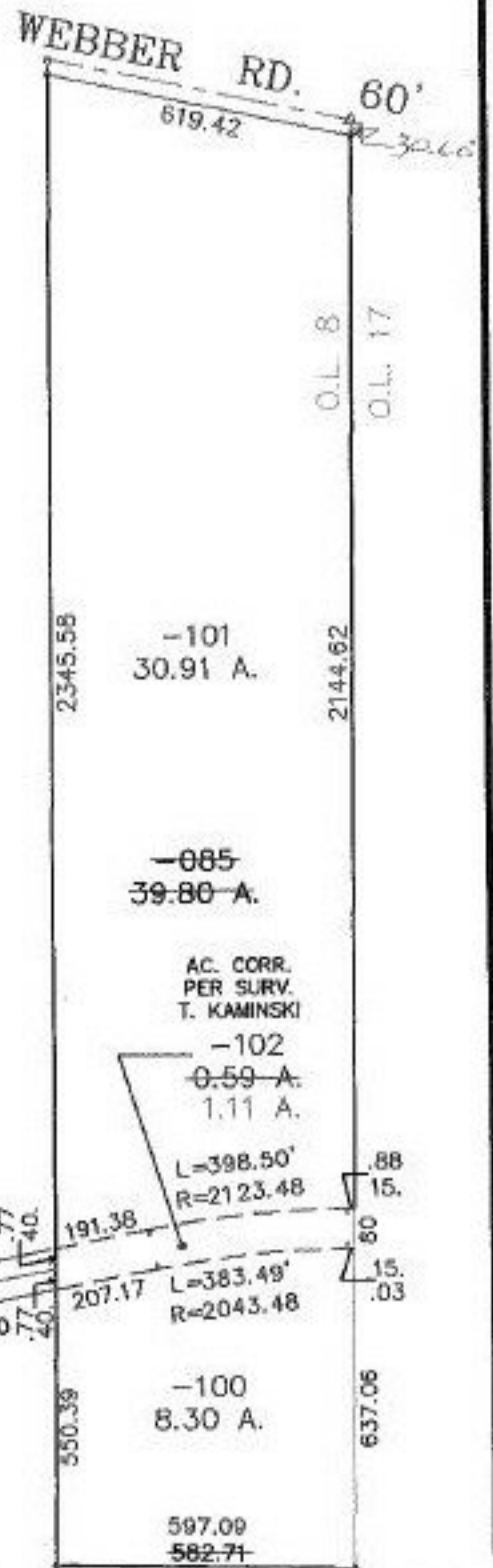

**SPLITS/DEEDS PROCESSED**  
 LORAIN COUNTY TAX MAP DEPARTMENT  
 226 MIDDLE AVE. ELYRIA, OHIO

SURVEYED BY: TERIN J. KAMINSKI  
 CLOSURE: 0.07 : 10,000  
 MAP PAGE(S): 4-B  
 APPROVED BY: TJS DATE: 01/05/99  
 SCALE: 1" = 400 PRIOR INSTRUMENT: DV 1282/160

*Handwritten initials*