

PARENT PARCEL: 04-00-008-104-089


CHILD PARCEL: 04-00-008-104-103 THRU -105

STARTING POINT: MON. BOX, CL OF PIN OAK PKWY, STA. 10+20.00

NO. 22696



WEBBER RD. 60'

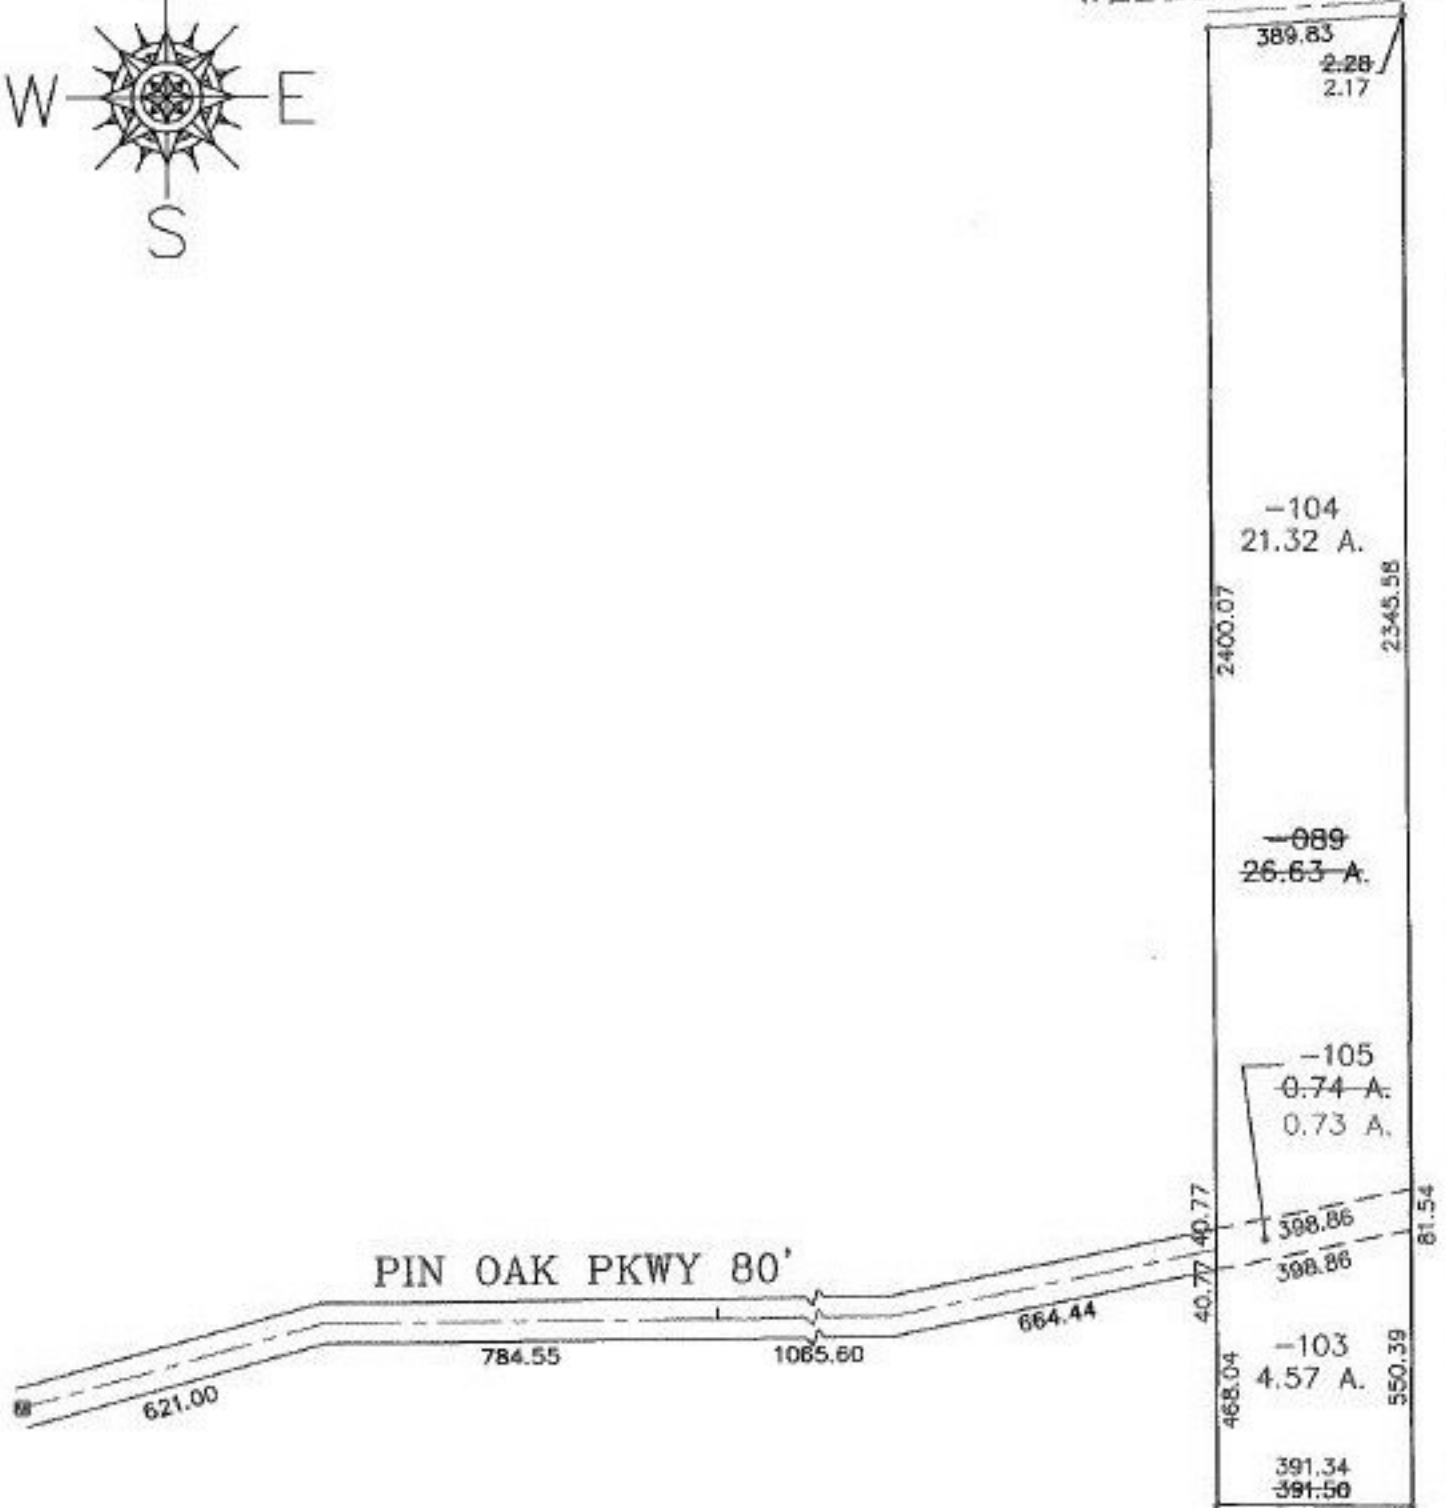

SPLITS/DEEDS PROCESSED

LORAIN COUNTY TAX MAP DEPARTMENT
226 MIDDLE AVE. ELYRIA, OHIO

SURVEYED BY: TERIN J. KAMINSKI

CLOSURE: 0.03 : 10,000

MAP PAGE(S): 4-B

APPROVED BY: IJS DATE: 01/05/99

SCALE: 1" = 400' PRIOR INSTRUMENT: OR 139/206