


PARENT PARCEL: 03-00-011-102-060

CHILD PARCEL: NONE


STARTING POINT: CL OF ABBE RD. & S.E. CORNER OF O.L. 11

NO. 22699-A

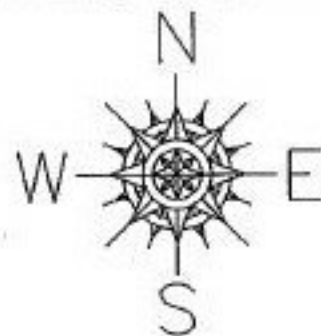

ACREAGE CORRECTION

TO CORRECT AC. CORR. ON #22523-D

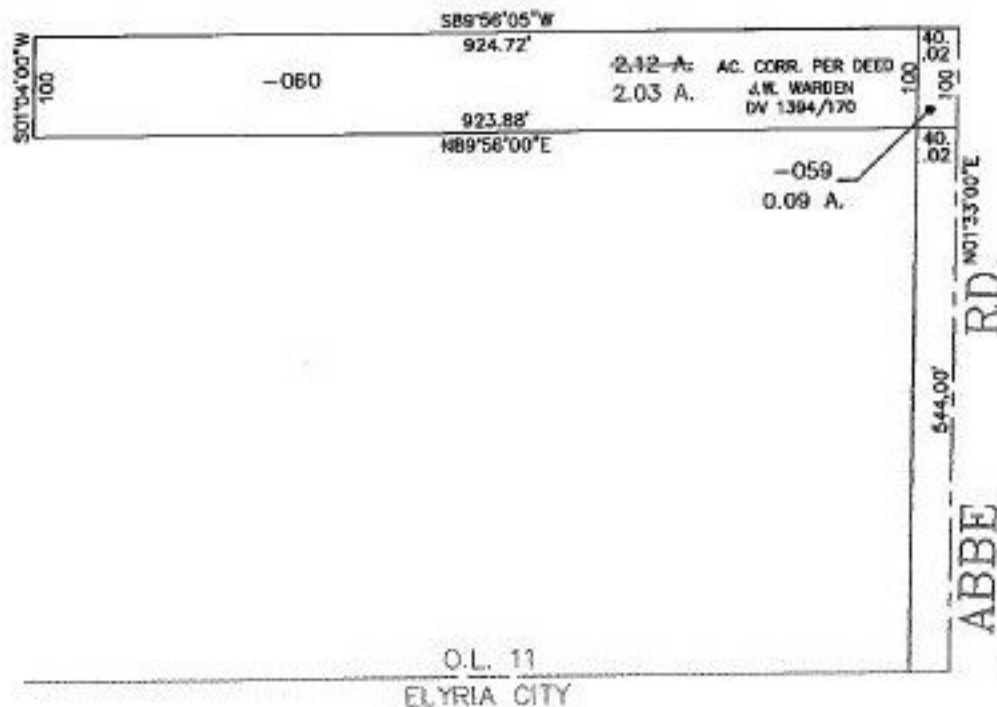

SPLITS/DEEDS PROCESSED
 LORAIN COUNTY TAX MAP DEPARTMENT
 226 MIDDLE AVE. ELYRIA, OHIO

SURVEYED BY: J.W. WARDEN & ASSOC.
 CLOSURE: 0.10 : 10,000
 MAP PAGE(S): 03-00-011-8
 APPROVED BY: TJS DATE: 11/03/98
 SCALE: 1" = 200' PRIOR INSTRUMENT: 970508365